


1 LOCATION OF WATER WELL:		Fraction			Section Number		Township Number		Range Number	
County:	Ford	SE	¼	SE	¼	SE	¼	15	T 27 S	R 26

Distance and direction from nearest town or city street address of well if located within city?

5-1/4 miles Sw of Dodge City on highway 56

2] WATER WELL OWNER:	Mrs. L H W Hall	
RR#, St. Address, Box # :	501 El Corto	Board of Agriculture, Division of Water Resources
City, State, ZIP Code :	Dodge City, Ks 67801	Application Number:

LOCATE WELL'S LOCATION WITH AN "X" IN SECTION BOX: 4 DEPTH OF COMPLETED WELL... 110... ft. ELEVATION: 95

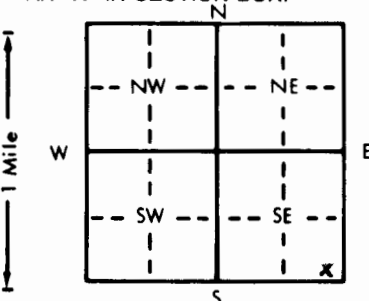

4 DEPTH OF COMPLETED WELL. 110' ft. ELEVATION: _____

Depth(s) Groundwater Encountered 1. 95' ft. 2. _____ ft. 3. _____ ft.

WELL'S STATIC WATER LEVEL 95' ft. below land surface measured on mo/day/yr 10-9-81

Pump test data: Well water was _____ ft. after _____ hours pumping _____ gpm

Est. Yield 10 gpm: Well water was _____ ft. after _____ hours pumping _____ gpm

Bore Hole Diameter 8" in. to 110' ft., and _____ in. to _____ ft.

WELL WATER TO BE USED AS:

5 Public water supply	8 Air conditioning	11 Injection well		
① Domestic	3 Feedlot	6 Oil field water supply	9 Dewatering	12 Other (Specify below)
2 Irrigation	4 Industrial	7 Lawn and garden only	10 Observation well	<u>Pasture well</u>

Was a chemical/bacteriological sample submitted to Department? Yes. _____ No. X _____; If yes, mo/day/yr sample was submitted _____

Water Well Disinfected? Yes X No _____

5 TYPE OF BLANK CASING USED: 5 Wrought iron 8 Concrete tile CASING JOINTS: Glued ☒ Clamped ☐
1 Steel 3 RMP (SR) 6 Asbestos-Cement 9 Other (specify below) Welded ☐
2 PVC 4 ABS 7 Fiberglass Threaded ☐
Blank casing diameter 5" in. to 90" ft. Dia. in. to . ft. Dia. in. to . ft.
Casing height above land surface 18 in. weight — lbs./ft. Wall thickness or gauge No. 250

TYPE OF SCREEN OR PERFORATION MATERIAL:

1 Steel	3 Stainless steel	5 Fiberglass	7 <u>PVC</u>	10 Asbestos-cement
2 Brass	4 Galvanized steel	6 Concrete tile	8 RMP (SR)	11 Other (specify)
			9 ABS	12 None used (open hole)

SCREEN OR PERFORATION OPENINGS ARE:

1 Continuous slot	3 Mill slot	5 Gauzed wrapped	8 Saw cut	11 None (open hole)
2 Louvered shutter	4 Key punched	6 Wire wrapped	9 Drilled holes	
		7 Torch cut	10 Other (specify)	

SCREEN-PERFORATED INTERVALS: From . . . 90 . . . ft. to . . . 110 . . . ft., From ft. to ft.
From ft. to ft., From ft. to ft.
GRAVEL PACK INTERVALS: From . . . 0 . . . ft. to . . . 3 . . . ft., From ft. to ft.
From 15 . . . ft. to 110 . . . ft., From ft. to ft.

5 GROUT MATERIAL: 1 Neat cement 2 Cement grout 3 Bentonite 4 Other

Grout Intervals: From 3 ft. to 15 ft. From ft. to ft. From ft. to ft.

What is the nearest source of possible contamination: *n/a - pasture*

1 Septic tank	4 Lateral lines	7 Pit privy	10 Livestock pens	14 Abandoned water well
2 Sewer lines	5 Cess pool	8 Sewage lagoon	11 Fuel storage	15 Oil well/Gas well
3 Watertight sewer lines	6 Seepage pit	9 Feedyard	12 Fertilizer storage	16 Other (specify below)
			13 Insecticide storage	

Direction from well? *N/A* How many feet? *N/A*

[illegible]

7] CONTRACTOR'S OR LANDOWNER'S CERTIFICATION: This water well was (1) constructed, (2) reconstructed, or (3) plugged under my jurisdiction and was completed on (mo/day/year) .. 10-12-81 .. and this record is true to the best of my knowledge and belief. Kansas

Water Well Contractor's License No.111..... This Water Well Record was completed on (mo/day/yr)10-12-81.....
under the business name of Gragg Well Drilling by (signature) *Sam Als*

INSTRUCTIONS: Use typewriter or ball point pen, PLEASE PRESS FIRMLY and PRINT clearly. Please fill in blanks, underline or circle the correct answers. Send top three copies to Kansas Department of Health and Environment, Division of Environment, Environmental Geology Section, Topeka, KS 66620. Send one to WATER WELL OWNER and retain one for your records.