


1 LOCATION OF WATER WELL:	Fraction	Section Number	Township Number	Range Number
County: <u>Gray</u>	<u>SW 1/4 SW 1/4 SW 1/4</u>	<u>16</u>	<u>T 27 S</u>	<u>R 27 EW</u>

Distance and direction from nearest town or city street address of well if located within city?

1 1/2 Mile East & 3 1/2 Miles North of Haggard

2 WATER WELL OWNER: Mike Dohrmann
 RR#, St. Address, Box # : 201 Leavenworth P.O. Box Board of Agriculture, Division of Water Resources
 City, State, ZIP Code : Ensign, Kansas 67841 Application Number:

3 LOCATE WELL'S LOCATION WITH AN "X" IN SECTION BOX: 4 DEPTH OF COMPLETED WELL... 213 ft. ELEVATION:

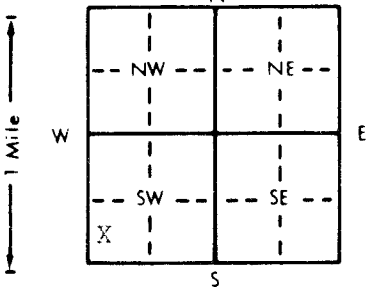

Depth(s) Groundwater Encountered 1. ft. 2. ft. 3. ft.
 WELL'S STATIC WATER LEVEL ... 123 ft. below land surface measured on mo/day/yr ... 12-27-95
 Pump test data: Well water was ft. after hours pumping gpm
 Est. Yield 10 gpm: Well water was ft. after hours pumping gpm
 Bore Hole Diameter ... 10 in. to 213 ft., and in. to ft.
 WELL WATER TO BE USED AS:
 1 Domestic 3 Feedlot 6 Oil field water supply 9 Dewatering 12 Other (Specify below) Stockwell
 2 Irrigation 4 Industrial 7 Lawn and garden only 10 Monitoring well
 Was a chemical/bacteriological sample submitted to Department? Yes No X; If yes, mo/day/yr sample was sub-
 mitted Water Well Disinfected? Yes X No

5 TYPE OF BLANK CASING USED:
 1 Steel 3 RMP (SR) 5 Wrought iron 8 Concrete tile CASING JOINTS: Glued X Clamped
 2 PVC 4 ABS 6 Asbestos-Cement 9 Other (specify below) Welded
 7 Fiberglass Threaded

Blank casing diameter ... 5 in. to 213 ft. Dia in. to ft. Dia in. to ft.
 Casing height above land surface ... 24 in. weight lbs./ft. Wall thickness or gauge No. 0-200 SSDK21

TYPE OF SCREEN OR PERFORATION MATERIAL:
 1 Steel 3 Stainless steel 5 Fiberglass 7 PVC 10 Asbestos-cement
 2 Brass 4 Galvanized steel 6 Concrete tile 8 RMP (SR) 11 Other (specify)
 9 ABS 12 None used (open hole)

SCREEN OR PERFORATION OPENINGS ARE:
 1 Continuous slot 3 Mill slot 5 Gauzed wrapped 8 Saw cut 11 None (open hole)
 2 Louvered shutter 4 Key punched 6 Wire wrapped 9 Drilled holes
 7 Torch cut 10 Other (specify)

SCREEN-PERFORATED INTERVALS: From ... 173 ft. to ... 213 ft. From ft. to ft.
 From ft. to ft. From ft. to ft.
 GRAVEL PACK INTERVALS: From ... 20 ft. to ... 213 ft. From ft. to ft.
 From ft. to ft. From ft. to ft.

6 GROUT MATERIAL: 1 Neat cement 2 Cement grout 3 Bentonite X 4 Other
 Grout Intervals: From ... 0 ft. to ... 20 ft., From ft. to ft. From ft. to ft.

What is the nearest source of possible contamination:
 1 Septic tank 4 Lateral lines 7 Pit privy 10 Livestock pens 14 Abandoned water well
 2 Sewer lines 5 Cess pool 8 Sewage lagoon 11 Fuel storage 15 Oil well/Gas well
 3 Watertight sewer lines 6 Seepage pit 9 Feedyard 12 Fertilizer storage 16 Other (specify below)
 13 Insecticide storage

Direction from well? South How many feet? 30

FROM	TO	LITHOLOGIC LOG	FROM	TO	PLUGGING INTERVALS
0	60	Topsoil & Clay			
60	195	Fine Sand & Clay			
195	197	Line (Very hard) & Clay			
197	213	Rock (Very hard) & Shale (Very Very hard)			

7 CONTRACTOR'S OR LANDOWNER'S CERTIFICATION: This water well was (1) constructed, (2) reconstructed, or (3) plugged under my jurisdiction and was completed on (mo/day/year) ... 12-28-95 and this record is true to the best of my knowledge and belief. Kansas Water Well Contractor's License No. ... 223 This Water Well Record was completed on (mo/day/yr) ... 1-24-96 under the business name of Dunham Drilling Company by (signature) Karen Dunham

OFFICE USE ONLY
T
R
EW
SEC.
1/4
1/4
1/4