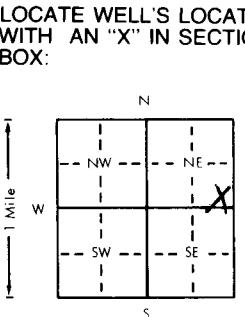


WATER WELL RECORD

Form WWC-5

KSA 82a-1212

1 LOCATION OF WATER WELL		Fraction SE $\frac{1}{4}$ SE $\frac{1}{4}$ NE $\frac{1}{4}$				Section Number 2	Township Number T 27 S	Range Number R 27 E/W	
County: Gray				Distance and direction from nearest town or city? $\frac{1}{4}$ miles South & 6 miles East & $\frac{1}{4}$ miles South of Cimarron, Kansas					Street address of well if located within city?
2 WATER WELL OWNER:		Tony McGee							
RR#, St. Address, Box #:		Board of Agriculture, Division of Water Resources							
City, State, ZIP Code:		Application Number:							
3 DEPTH OF COMPLETED WELL		145	ft. Bore Hole Diameter	8	in. to	145	ft., and	in. to	ft.
Well Water to be used as:		5 Public water supply		8 Air conditioning		11 Injection well			
1 Domestic		6 Oil field water supply		9 Dewatering		12 Other (Specify below)			
2 Irrigation		7 Lawn and garden only		10 Observation well					
Well's static water level		89	ft. below land surface measured on	August	month	15th	day	1979	year
Pump Test Data		Well water was	100 ft. after	2 hours pumping	50 gpm				
Est. Yield		box 60 gpm	Well water was	ft. after	hours pumping	gpm			
4 TYPE OF BLANK CASING USED:		5 Wrought iron	8 Concrete tile	Casing Joints: Glued XXX. Clamped					
1 Steel		3 BMP (SR)	6 Asbestos-Cement	9 Other (specify below)		Welded			
2 PVC		4 ABS	7 Fiberglass			Threaded			
Blank casing dia		5 in. to 145	ft., Dia	in. to		ft., Dia	in. to	ft.	
Casing height above land surface		12 in.	weight			lbs./ft. Wall thickness or gauge No	250		
TYPE OF SCREEN OR PERFORATION MATERIAL:		7 PVC	10 Asbestos-cement						
1 Steel		3 Stainless steel	5 Fiberglass	8 BMP (SR)	11 Other (specify)				
2 Brass		4 Galvanized steel	6 Concrete tile	9 ABS	12 None used (open hole)				
Screen or Perforation Openings Are:		5 Gauzed wrapped	8 Saw cut	10 None (open hole)					
1 Continuous slot		3 Mill slot	6 Wire wrapped	9 Drilled holes					
2 Louvered shutter		4 Key punched	7 Torch cut	10 Other (specify)					
Screen-Perforation Dia		1/8 in. to 20	ft., Dia	in. to		ft., Dia	in. to	ft.	
Screen-Perforated Intervals:		From 120	ft. to 140	ft.	From	ft.	ft. to	ft.	
Gravel Pack Intervals:		From 10	ft. to 145	ft.	From	ft.	ft. to	ft.	
From		ft. to		ft., From	ft.	ft. to			
5 GROUT MATERIAL:		1 Neat cement	2 Cement grout	3 Bentonite	4 Other				
Grouted Intervals:		From 10	ft. to 20	ft., From	ft. to	ft., From	ft. to	ft.	
What is the nearest source of possible contamination:		1 Septic tank	4 Cess pool	7 Sewage lagoon	10 Fuel storage	14 Abandoned water well			
		2 Sewer lines	5 Seepage pit	8 Feed yard	11 Fertilizer storage	15 Oil well/Gas well			
		3 Lateral lines	6 Pit privy	9 Livestock pens	12 Insecticide storage	16 Other (specify below)			
Direction from well		West	How many feet	50	? Water Well Disinfected? Yes XXX	No			
Was a chemical/bacteriological sample submitted to Department?		Yes		No XXX	If yes, date sample				
was submitted		month	day	year	Pump Installed? Yes XXX	No			
If Yes: Pump Manufacturer's name		Goulds		Model No. 13EM	HP $\frac{1}{2}$	Volts 230			
Depth of Pump Intake		126	ft.	Pumps Capacity rated at	13	gal./min.			
Type of pump:		1 Submersible	2 Turbine	3 Jet	4 Centrifugal	5 Reciprocating	6 Other		
6 CONTRACTOR'S OR LANDOWNER'S CERTIFICATION:		This water well was (1) constructed, (2) reconstructed, or (3) plugged under my jurisdiction and was completed on August month 15th day 1979							
		and this record is true to the best of my knowledge and belief. Kansas Water Well Contractor's License No. 179							
		This Water Well Record was completed on August month 22nd day 1979 year under the business							
		name of JOE'S WELL SERVICE - CIMARRON, KS. by (signature) Larry Crick							
7 LOCATE WELL'S LOCATION WITH AN "X" IN SECTION BOX:		FROM	TO	LITHOLOGIC LOG		FROM	TO	LITHOLOGIC LOG	
		0	15	Top soil & clay					
		15	30	Clay					
		30	45	Clay & fine sand					
		45	60	Fine sand					
		60	75	Fine to coarse sand					
		75	105	Coarse sand					
		105	120	Coarse sand & clay layers					
		120	135	Coarse sand & white rock					
		135	150	White rock					
		150	160	White rock & blue shale					
ELEVATION:									
Depth(s) Groundwater Encountered		1	ft. 2	ft. 3	ft. 4	ft.	(Use a second sheet if needed)		
INSTRUCTIONS: Use typewriter or ball point pen, please press firmly and PRINT clearly. Please fill in blanks, underline or circle the correct answers. Send top three copies to Kansas Department of Health and Environment, Division of Environment, Water Well Contractors, Topeka, KS 66620. Send one to WATER WELL OWNER and retain one for your records.									