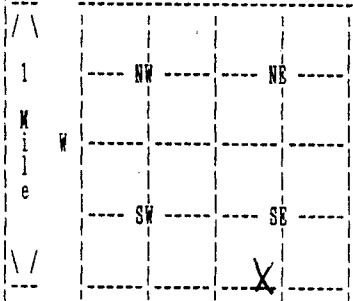


## WATER WELL RECORD Form WWC-5 KSA 82a-1212

1 LOCATION OF WATER WELL:	Fraction COUNTY: GRAY	SE 1/4 SW 1/4 SE 1/4	Section Number 5	Township Number T 27 S	Range Number R 27 W
---------------------------	--------------------------	----------------------	---------------------	---------------------------	------------------------

Distance and direction from nearest town or city street address of well if located within city?  
FROM CIMARRON - 6 M. S. ON HIGHWAY 23 2 1/2 E. - N. SIDE ROAD

2 WATER WELL OWNER: JANTZ, LEO, Don L. Schminke and Henry C. Schminke  
RR#, St. Address, Box #: 1912 THOMPSON  
City, State, ZIP code : DODGE CITY, KS 67801- Board of Agriculture, Division of Water Resources  
Application Number:

3 LOCATE WELL'S LOCATION WITH AN "X" IN SECTION BOX:	4 DEPTH OF COMPLETED WELL 120 ELEVATION: 0 Depth(s) Groundwater Encountered 1. 0 ft. 2. 0 ft. 3. 0 ft.
	WELL'S STATIC WATER LEVEL 0 ft. below land surface measured on mo/day/yr Pump test data: Well water was 0 ft. after 0 hours pumping 0 gpm
	Estimated Yield 0 gpm: Well water was 0 ft. after 0 hours pumping 0 gpm Bore Hole Diameter 4 in. to 120 ft., and in. to 0 ft.
WELL WATER WAS: DOMESTIC	
Was a chemical/bacteriological sample submitted to department? No; If yes, mo/day/yr sample was submitted Water well disinfected? Yes	

5 TYPE OF BLANK CASING USED: WROUGHT IRON CASING JOINTS:  
Blank casing diameter 4 in. to 120 ft., Dia in. to 0 ft., Dia in. to 0 ft.  
Casing height above land surface 0 in., weight 0 lbs/ft. Wall thickness or gauge No.  
TYPE OF SCREEN OR PERFORATION MATERIAL:  
SCREEN OR PERFORATION OPENINGS ARE:

SCREEN PERFORATED INTERVALS:	From 0 ft. to 0 ft., From 0 ft. to 0 ft.
GRAVEL PACK INTERVALS:	From 0 ft. to 0 ft., From 0 ft. to 0 ft.
From 0 ft. to 0 ft., From 0 ft. to 0 ft.	

6 GROUT MATERIAL BENTONITE  
Grout Intervals: From 0 ft. to 0 ft., From 0 ft. to 0 ft., From 0 ft. to 0 ft.  
What is the nearest source of possible contamination: NONE  
Direction from well? How many feet? 0

FROM	TO	LITHOLOGIC LOG	FROM	TO	PLUGGING INTERVALS
			0	3	TOP SOIL
			3	6	CEMENT
			6	25	BENTONITE GROUT
			25	120	FILL SAND
			0	0	
			0	0	
			0	0	
			0	0	

7 CONTRACTOR'S OR LANDOWNER'S CERTIFICATION: This water well was Plugged under my jurisdiction and was completed on (mo/day/year) 07/26/93 and this record is true to the best of my knowledge and belief. Kansas Water Well Contractor's License No. 179 This Water Well Record was completed on (mo/day/yr) 07/30/93 under the business name of JOE'S WELL SERVICE, INC. by (signature) *Joe Schminke*