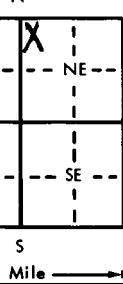
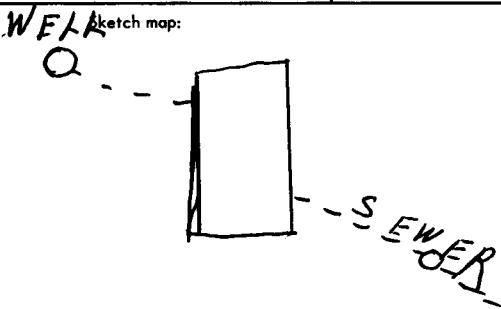


USE TYPEWRITER OR BALL
POINT PEN-PRESS FIRMLY,
PRINT CLEARLY.

WATER WELL RECORD
KSA 82g-1201-1215

Kansas Department of Health and
Environment-Division of Environment
(Water well Contractors)
Topeka, Kansas 66620

1. Location of well:	County Gray	Fraction NW 1/4 NW 1/4 NE 1/4	Section number 9	Township number T 27	Range number S R 27
2. Distance and direction from nearest town or city:	5 miles south & 3 1/2 miles east of Cimarron, Kansas		3. Owner of well: R.R. or street: City, state, zip code:	Don Culver Ensign, Kansas 67841	
4. Locate with "X" in section below:			<i>WFLA</i> sketch map: 		
5. Type and color of material	From	To	6. Bore hole dia. 8 in. Completion date 3-8-78 Well depth 195 ft.		
Top soil & clay	0	15	7. <input checked="" type="checkbox"/> Cable tool <input checked="" type="checkbox"/> Rotary <input type="checkbox"/> Driven <input type="checkbox"/> Dug <input type="checkbox"/> Hollow rod <input type="checkbox"/> Jetted <input type="checkbox"/> Bored <input type="checkbox"/> Reverse rotary		
Clay	15	30	8. Use: <input checked="" type="checkbox"/> Domestic <input type="checkbox"/> Public supply <input type="checkbox"/> Industry <input type="checkbox"/> Irrigation <input type="checkbox"/> Air conditioning <input type="checkbox"/> Stock <input type="checkbox"/> Lawn <input type="checkbox"/> Oil field water <input type="checkbox"/> Other		
Clay & fine sand	30	45	9. Casing: Material RMP Height: Above ground 12 in. Threaded <input type="checkbox"/> Welded <input type="checkbox"/> Surface 12 in. RMP <input checked="" type="checkbox"/> PVC Weight lbs./ft. Dia. 5 in. to 195 ft. depth Wall Thickness: inches or Dia. in. to ft. depth gage No. 250		
Clay	45	60	10. Screen: Manufacturer's name Sunflower Type RMP Dia. 5" <input checked="" type="checkbox"/> 1/8" Length 20 ft. Slope <input checked="" type="checkbox"/> Set between 170 ft. and 190 ft. ft. and ft. Gravel pack? <input checked="" type="checkbox"/> yes Size range of material 1/4"		
Clay & fine sand	60	75	11. Static water level: 88 ft. below land surface Date 3-8-78		
Fine to medium sand	75	90	12. Pumping level below land surfaces: 88 ft. after 1 hrs. pumping 50 g.p.m. ft. after hrs. pumping g.p.m. Estimated maximum yield 65 g.p.m.		
Medium to coarse sand	90	105	13. Water sample submitted: mo./day/yr. Yes <input checked="" type="checkbox"/> No Date		
Coarse sand & clay layers	105	120	14. Well head completion: <input checked="" type="checkbox"/> Pitless adapter 212 inches above grade		
Fine sand	120	135	15. Well grouted? <input checked="" type="checkbox"/> yes With: <input checked="" type="checkbox"/> Neat cement <input type="checkbox"/> Bentonite <input type="checkbox"/> Concrete Depth: From 6 ft. to 18 ft.		
Fine to medium sand	135	165	16. Nearest source of possible contamination: ft. 125 Direction SE Type Sewer Well disinfected upon completion? <input checked="" type="checkbox"/> Yes <input type="checkbox"/> No		
Medium sand	165	180	17. Pump: <input checked="" type="checkbox"/> Not installed Manufacturer's name Model number HP Volts Length of drop pipe ft. capacity g.p.m.		
Medium to coarse sand	180	195	Type: <input type="checkbox"/> Submersible <input type="checkbox"/> Turbine <input type="checkbox"/> Jet <input type="checkbox"/> Reciprocating <input type="checkbox"/> Centrifugal <input type="checkbox"/> Other		
Clay	195	210	18. Elevation: (Use a second sheet if needed)		
Clay & shale	210	220	19. Remarks:		
Topography: <input type="checkbox"/> Hill <input type="checkbox"/> Slope <input checked="" type="checkbox"/> Upland <input type="checkbox"/> Valley	20. Water well contractor's certification: This well was drilled under my jurisdiction and this report is true to the best of my knowledge and belief. JOE'S WELL SERVICE 0179 Business name <input type="checkbox"/> License No. Address <input type="checkbox"/> Box 174 Cimarron, Ks. Signed <i>Larry Crick</i> Date 4-7-78 Authorized representative				

Forward the white, blue and pink copies to the Department of Health and Environment

Form WWC-5