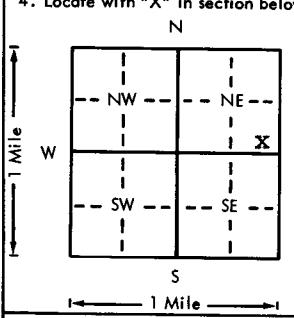


USE TYPEWRITER OR BALL
POINT PEN-PRESS FIRMLY,
PRINT CLEARLY.

WATER WELL RECORD
KSA 82a-1201-1215

Kansas Department of Health and
Environment-Division of Environment
(Water well Contractors)
Topeka, Kansas 66620

1. Location of well:	County Gray	Fraction SE 1/4 SE 1/4 NE 1/4	Section number 10	Township number T 27	Range number S R 27 W E 8																		
2. Distance and direction from nearest town or city: 4 miles north, 1 mile east, $\frac{1}{2}$ mile north of Ensign, Ks. Street address of well location if in city:	3. Owner of well: Walter Redger R.R. or street: City, state, zip code: Montezuma, Kansas 67867																						
4. Locate with "X" in section below: 	Sketch map:																						
<p>5. Type and color of material</p> <table border="1"> <tr> <td>Top soil</td> <td>0</td> <td>6</td> </tr> <tr> <td>Sandy clay</td> <td>6</td> <td>42</td> </tr> <tr> <td>Fine sand</td> <td>42</td> <td>110</td> </tr> <tr> <td>Med. to lar. sand - streaks of large rocks</td> <td>110</td> <td>183</td> </tr> <tr> <td>Medium sand</td> <td>183</td> <td>209</td> </tr> <tr> <td>Black shale</td> <td>209</td> <td>220</td> </tr> </table>						Top soil	0	6	Sandy clay	6	42	Fine sand	42	110	Med. to lar. sand - streaks of large rocks	110	183	Medium sand	183	209	Black shale	209	220
Top soil	0	6																					
Sandy clay	6	42																					
Fine sand	42	110																					
Med. to lar. sand - streaks of large rocks	110	183																					
Medium sand	183	209																					
Black shale	209	220																					
<p>(Use a second sheet if needed)</p>																							
18. Elevation:	19. Remarks:																						
Topography: <input type="checkbox"/> Hill <input type="checkbox"/> Slope <input type="checkbox"/> Upland <input checked="" type="checkbox"/> Valley	<p>20. Water well contractor's certification: This well was drilled under my jurisdiction and this report is true to the best of my knowledge and belief. Friesen Windmill 252 Business name Address Meade, Kansas 67864 License No. Signed John Friesen Date 2-24-78 Authorized representative</p>																						

Forward the white, blue and pink copies to the Department of Health and Environment

Form WWC-5