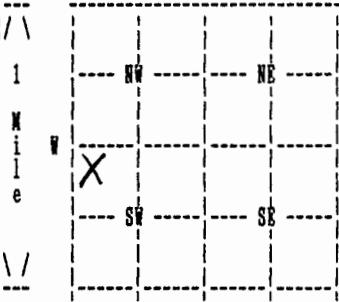


WATER WELL RECORD Form WWC-5 KSA 82a-1212

1 LOCATION OF WATER WELL:	Fraction COUNTY: GRAY	NW 1/4 NW 1/4 SW 1/4	Section Number 22	Township Number T 27 S	Range Number R 27 W
---------------------------	--------------------------	----------------------	----------------------	---------------------------	------------------------

Distance and direction from nearest town or city street address of well if located within city?
FROM ENSIGN, 2 1/2 NORTH, 2 WEST AND 1/2 SOUTH

2 WATER WELL OWNER:	PHILLIPS, EILEEN	Board of Agriculture, Division of Water Resources
RR#, St. Address, Box #:	67841-	Application Number:
City, State, ZIP code :	ENSIGN, KS	

3 LOCATE WELL'S LOCATION WITH AN "X" IN SECTION BOX:	4 DEPTH OF COMPLETED WELL 171 ELEVATION: 0 Depth(s) Groundwater Encountered 1. 0 ft. 2. 0 ft. 3. 0 ft.
	WELL'S STATIC WATER LEVEL 169 ft. below land surface measured on mo/day/yr 03/10/93 Pump test data: Well water was 0 ft. after 0 hours pumping 0 gpm
	Estimated Yield 0 gpm: Well water was 0 ft. after 0 hours pumping 0 gpm
	Bore Hole Diameter in. to 0 ft., and in. to 0 ft.
	WELL WATER WAS: DOMESTIC
Was a chemical/bacteriological sample submitted to department? No ; If yes, mo/day/yr sample was submitted Water well disinfected? Yes	

5 TYPE OF BLANK CASING USED: STEEL	CASING JOINTS: GLUED
Blank casing diameter 6 in. to 171 ft., Dia in. to 0 ft., Dia in. to 0 ft.	
Casing height above land surface 48 in., weight 0 lbs/ft. Wall thickness or gauge No.	

TYPE OF SCREEN OR PERFORATION MATERIAL: STEEL *NA*

SCREEN OR PERFORATION OPENINGS ARE: *NA*

SCREEN PERFORATED INTERVALS:	From <i>NA</i> ft. to <i>NA</i> ft., From 0 ft. to 0 ft.
	From 0 ft. to 0 ft., From 0 ft. to 0 ft.
GRAVEL PACK INTERVALS:	From 0 ft. to 0 ft., From 0 ft. to 0 ft.
	From 0 ft. to 0 ft., From 0 ft. to 0 ft.

6 GROUT MATERIAL	
Grout Intervals: From 0 ft. to 0 ft., From 0 ft. to 0 ft., From 0 ft. to 0 ft.	
What is the nearest source of possible contamination: NONE	
Direction from well?	How many feet? 0

FROM	TO	LITHOLOGIC LOG	FROM	TO	PLUGGING INTERVALS
			0	4	CEMENT
			4	42	BENTONITE GROUT & SAND MIX
			42	171	PILL SAND
			0	0	
			0	0	
			0	0	
			0	0	
			0	0	
			0	0	

7 CONTRACTOR'S OR LANDOWNER'S CERTIFICATION: This water well was Plugged under my jurisdiction and was completed on (mo/day/year) 03/10/93 and this record is true to the best of my knowledge and belief. Kansas Water Well Contractor's License No. 179 This Water Well Record was completed on (mo/day/yr) 03/15/93 under the business name of JOE'S WELL SERVICE, INC. by (signature) <i>Justine Clark</i>
--