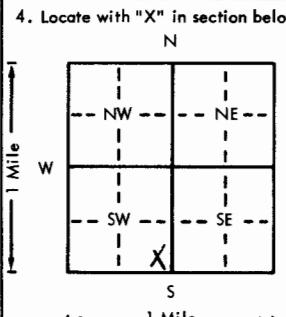


USE TYPEWRITER OR BALL
POINT PEN-PRESS FIRMLY,
PRINT CLEARLY.

WATER WELL RECORD
KSA 82a-1201-1215

Kansas Department of Health and
Environment-Division of Environment
(Water well Contractors)
Topeka, Kansas 66620

1. Location of well:	County Gray	Fraction SE 1/4 SE 1/4 SW 1/4	Section number #29	Township number T #27	Range number S R #27 W
2. Distance and direction from nearest town or city: 3 miles east of Cimarron, Ks.	9 miles south and Street address of well location if in city:		3. Owner of well: Irvin Koppish		
		R.R. or street: City, state, zip code: Ingalls, Kansas 67853			
4. Locate with "X" in section below: 	<p>Sketch map: </p>		<p>6. Bore hole dia. 6 in. Completion date _____ Well depth 220 ft. 9-14-75</p> <p>7. <input checked="" type="checkbox"/> Cable tool <input type="checkbox"/> Rotary <input type="checkbox"/> Driven <input type="checkbox"/> Dug <input type="checkbox"/> Hollow rod <input type="checkbox"/> Jetted <input type="checkbox"/> Bored <input type="checkbox"/> Reverse rotary</p> <p>8. Use: <input checked="" type="checkbox"/> Domestic <input type="checkbox"/> Public supply <input type="checkbox"/> Industry <input type="checkbox"/> Irrigation <input type="checkbox"/> Air conditioning <input type="checkbox"/> Stock <input type="checkbox"/> Lawn <input type="checkbox"/> Oil field water <input type="checkbox"/> Other</p> <p>9. Casing: Material RMP Height: Above 3000 Threaded <input type="checkbox"/> Welded <input type="checkbox"/> Surface 12 in. RMP <input checked="" type="checkbox"/> PVC <input type="checkbox"/> Weight _____ lbs./ft. Dia. 5 in. to 220 ft. depth Wall Thickness: inches or Dia. _____ in. to _____ ft. depth gage No. 250</p>		
5. Type and color of material			From	To	10. Screen: Manufacturer's name Jess & Lowell
Top soil & clay	0	15	Type RMP Dia. 5"		
Clay & fine sand	15	30	Slot/gauze 1/8" Length 20ft.		
Clay	30	45	Set between 195 ft. and 215 ft.		
Clay & fine sand mixed	45	75	Gravel pack? <input checked="" type="checkbox"/> Size range of material 1/4"		
Fine sand	75	120	11. Static water level: 147 ft. below land surface Date 9-14-75		
Fine sand & clay	120	135	12. Pumping level below land surfaces: ft. after hrs. pumping g.p.m. ft. after hrs. pumping g.p.m. Estimated maximum yield g.p.m.		
Fine sand	135	150	13. Water sample submitted: mo./day/yr. Yes <input checked="" type="checkbox"/> No Date _____		
Fine to medium sand	150	165	14. Well head completion: <input checked="" type="checkbox"/> Pitless adapter 12 Inches above grade		
Medium to coarse sand	165	195	15. Well grouted? <input checked="" type="checkbox"/> yes With: <input checked="" type="checkbox"/> Neat cement <input type="checkbox"/> Bentonite <input type="checkbox"/> Concrete Depth: From 6 ft. to 15 ft.		
Medium to coarse sand	195	210	16. Nearest source of possible contamination: ft. 60 Direction SW Type Sewer		
Coarse rock	210	225	Well disinfected upon completion? <input checked="" type="checkbox"/> Yes <input type="checkbox"/> No		
(Use a second sheet if needed)			17. Pump: Not installed Manufacturer's name Flint & Walling Model number 10BK9 HP 1 Volts 230 Length of drop pipe 168 ft. capacity 19 g.p.m. Type: <input checked="" type="checkbox"/> Submersible <input type="checkbox"/> Turbine <input type="checkbox"/> Jet <input type="checkbox"/> Reciprocating <input type="checkbox"/> Centrifugal <input type="checkbox"/> Other		
18. Elevation:	19. Remarks:		20. Water well contractor's certification: This well was drilled under my jurisdiction and this report is true to the best of my knowledge and belief. Joe's Well Service 179 Business name <input type="checkbox"/> License No. Address Box 174 Cimarron, Ks. Signed <input type="checkbox"/> Date 12-20-75 Authorized representative		
Topography: <input type="checkbox"/> Hill <input type="checkbox"/> Slope <input checked="" type="checkbox"/> Upland <input type="checkbox"/> Valley					