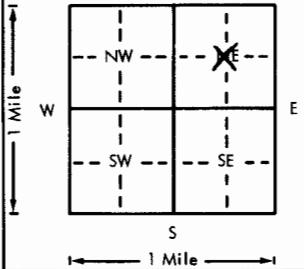


USE TYPEWRITER OR BALL
POINT PEN-PRESS FIRMLY,
PRINT CLEARLY.

WATER WELL RECORD
KSA 82a-1201-1215

Kansas Department of Health and
Environment-Division of Environment
(Water well Contractors)
Topeka, Kansas 66620

1. Location of well:	County Gray	Fraction 1/4	Center of 1/4 NE 1/4	Section number 31	Township number T 27 S	Range number R 27 E (W)	
2. Distance and direction from nearest town or city: 4 W. & 3 1/4 N. of Ensign Street address of well location if in city:	3. Owner of well: Evelyn Ettling R.R. or street: 104 Carefree City, state, zip code: Dodge City, KS 67801						
4. Locate with "X" in section below: Sketch map: N  W E 1 Mile S 1 Mile	6. Bore hole dia. 26 in. Completion date 12-6-76 Well depth 225 ft.						
5. Type and color of material See attachment	From	To	7. <input type="checkbox"/> Cable tool <input type="checkbox"/> Rotary <input type="checkbox"/> Driven <input type="checkbox"/> Dug <input type="checkbox"/> Hollow rod <input type="checkbox"/> Jetted <input type="checkbox"/> Bored <input checked="" type="checkbox"/> Reverse rotary				
			8. Use: <input type="checkbox"/> Domestic <input type="checkbox"/> Public supply <input type="checkbox"/> Industry <input checked="" type="checkbox"/> Irrigation <input type="checkbox"/> Air conditioning <input type="checkbox"/> Stock <input type="checkbox"/> Lawn <input type="checkbox"/> Oil field water <input type="checkbox"/> Other				
			9. Casing: Material <input checked="" type="checkbox"/> Steel Height: Above or below Threaded <input type="checkbox"/> Welded <input type="checkbox"/> Surface 12 in. RMP <input type="checkbox"/> PVC <input type="checkbox"/> Weight 36 lbs./ft. Dia. 16 in. to 225 ft. depth Wall Thickness: inches or Dia. <input type="checkbox"/> in. to <input type="checkbox"/> ft. depth gage No. 250				
			10. Screen: Manufacturer's name <input type="checkbox"/> Johnson Type <input checked="" type="checkbox"/> Continuous Dia. 16" Slot/gauze 125 Length 40' Set between 205 ft. and 165 ft. ft. and <input type="checkbox"/> ft. Gravel pack? <input checked="" type="checkbox"/> Yes Size range of material <input type="checkbox"/> 1/4 <input checked="" type="checkbox"/> 1/8				
			11. Static water level: <input type="checkbox"/> mo./day/yr. 147 ft. below land surface Date 12-7-76				
			12. Pumping level below land surfaces: 166 ft. after <input type="checkbox"/> hrs. pumping 1435 g.p.m. <input type="checkbox"/> ft. after <input type="checkbox"/> hrs. pumping <input type="checkbox"/> g.p.m. Estimated maximum yield <input type="checkbox"/> g.p.m.				
			13. Water sample submitted: <input type="checkbox"/> mo./day/yr. Yes <input checked="" type="checkbox"/> No Date				
			14. Well head completion: <input type="checkbox"/> Pitless adapter 12 Inches above grade				
			15. Well grouted? <input checked="" type="checkbox"/> YES With: <input type="checkbox"/> Neat cement <input checked="" type="checkbox"/> Bentonite <input type="checkbox"/> Concrete Depth: From 0 ft. to 10 ft.				
			16. Nearest source of possible contamination: <input type="checkbox"/> observed ft. <input type="checkbox"/> Direction <input type="checkbox"/> Type <input type="checkbox"/> Well disinfected upon completion? <input type="checkbox"/> Yes <input checked="" type="checkbox"/> No				
			17. Pump: <input checked="" type="checkbox"/> Not installed Manufacturer's name <input type="checkbox"/> Model number <input type="checkbox"/> HP <input type="checkbox"/> Volts <input type="checkbox"/> Length of drop pipe <input type="checkbox"/> ft. capacity <input type="checkbox"/> g.p.m. Type: <input type="checkbox"/> Submersible <input type="checkbox"/> Turbine <input type="checkbox"/> Jet <input type="checkbox"/> Reciprocating <input type="checkbox"/> Centrifugal <input type="checkbox"/> Other				
(Use a second sheet if needed)						20. Water well contractor's certification: This well was drilled under my jurisdiction and this report is true to the best of my knowledge and belief. Henkle Drig. & Supply 145 Business name <input type="checkbox"/> License No. <input type="checkbox"/> Address <input type="checkbox"/> BOX 639 Garden City, KS 12-29- Signed <input type="checkbox"/> E. L. Bothwell <input type="checkbox"/> Date <input type="checkbox"/> Authorized representative <input type="checkbox"/>	
18. Elevation: Flat	19. Remarks: Topography: <input type="checkbox"/> Hill <input type="checkbox"/> Slope <input type="checkbox"/> Upland <input type="checkbox"/> Valley						

DRILLERS TEST LOG

CUSTOMERS NAME Evelyn Ettling DATE 10-6-76
 STREET ADDRESS TEST # 1 E. Loy 230'
 CITY & STATE Dodge City, KS DRILLER Rector
 COUNTY Gray QUARTER NE SECTION 31 TOWNSHIP 27 RANGE 27
 LOCATION Center of 1/4

%	DRILLED FOOTAGE			Description of Strata	WELL LOCATION Static Water Level Proposed Well Depth
	From	Pay	To		
	0		2	Top soil	
	2		25	Brown sandy clay	
	25		75	Sand fine to med.	
	75		103	Brown sandy clay and sand	
	103		130	Brown clay and caliche	
	130		140	Brown sandy clay and sand med. coarse	
75	140	60	200	Sand fine med. coarse, med. to small gravel, loose, used lots of water, mixed 3 sacks gel at 200'	
85	200	20	220	Sand and gravel, small and large, ragged, (loose), used lots of water, mud heavy	
	220		221	Clay and lime rock	
	221		230	Shale (hard), used pull down	
			80		
				TOTAL DEPTH OF WELL 225'	

Pivot wasn't located. Set rig up according to pivot.