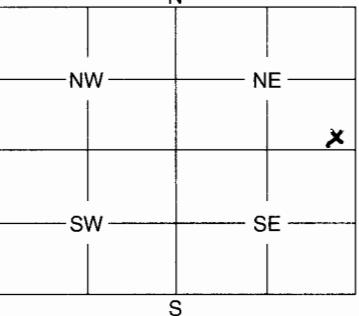


WATER WELL PLUGGING RECORD Form WWC-5P KSA 82a-1212 ID NO. _____

1	LOCATION OF WATER WELL: County: <i>Gray</i>	Fraction <i>SE SE NE 1/4 1/4 1/4</i>	Section Number <i>2</i>	Township Number <i>27</i>	Range Number <i>27</i>	E/W <i>E</i>																								
Distance and direction from nearest town or city street address of well if located within city? <i>From Ensign, 5 1/2 miles north</i>																														
2	WATER WELL OWNER: RR #, St. Address, Box #: <i>Charl's Brooks P.O. Box 67</i>	Board of Agriculture, Division of Water Resources Application Number: <i>Ensign, KS 67841</i>																												
3	MARK WELL'S LOCATION WITH AN "X" IN SECTION BOX: 	4	DEPTH OF WELL <i>144</i> ft.	WELL'S STATIC WATER LEVEL <i>134</i> ft.	WELL WAS USED AS:																									
			<input checked="" type="checkbox"/> Domestic 2 Irrigation 3 Feedlot 4 Industrial	5 Public Water Supply 6 Oil Field Water Supply 7 Domestic (Lawn & Garden) 8 Air Conditioning	9 Dewatering 10 Monitoring Well 11 Injection Well 12 Other																									
			Was a chemical / bacteriological sample submitted to Department? Yes No <i>X</i> If yes, mo/day/yr sample was submitted																											
			Water Well Disinfected: Yes <i>X</i> No																											
5	TYPE OF BLANK CASING USED: 1 Steel <input checked="" type="checkbox"/> RMP (SR) 5 Wrought 7 Fiberglass 9 Other (Specify below) 2 PVC <input type="checkbox"/> ABS 6 Asbestos-Cement 8 Concrete Tile																													
	Blank casing diameter <i>5</i> in. Was casing pulled? Yes No <i>X</i> If yes, how much																													
	Casing height above or below land surface <i>48</i> in.																													
6	GROUT PLUG MATERIAL: 1 Neat cement 2 Cement grout <input checked="" type="checkbox"/> Bentonite 4 Other																													
	Grout Plug Intervals: From <i>4</i> ft. to <i>24</i> ft., From ft. to ft., From ft. to ft.																													
	What is the nearest source of possible contamination: 1 Septic tank 6 Seepage pit 11 Fuel storage 16 Other (specify below) 2 Sewer lines 7 Pit privy 12 Fertilizer storage 3 Watertight sewer lines 8 Sewage lagoon 13 Insecticide storage 4 Lateral lines 9 Feedyard 14 Abandoned water well 5 Cess pool <input checked="" type="checkbox"/> Livestock pens 15 Oil well/Gas well																													
	Direction from well? <i>South</i> How many feet? <i>50</i>																													
<table border="1"> <thead> <tr> <th>FROM</th> <th>TO</th> <th>PLUGGING MATERIALS</th> </tr> </thead> <tbody> <tr> <td><i>4</i></td> <td><i>24</i></td> <td><i>Bentonite chips</i></td> </tr> <tr> <td><i>24</i></td> <td><i>134</i></td> <td><i>Compacted clay</i></td> </tr> <tr> <td><i>134</i></td> <td><i>144</i></td> <td><i>Chlorinated sand</i></td> </tr> <tr> <td> </td> <td> </td> <td> </td> </tr>
7	CONTRACTOR'S OF LANDOWNER'S CERTIFICATION: This water well was plugged under my jurisdiction and was completed on (mo/day/year) <i>3/15/09</i> and this record is true to the best of my knowledge and belief. Kansas Water Well Contractor's License No. <i>533</i> This Water Well Record was completed on (mo/day/year) <i>3/27/09</i> under the business name of <i>JanTech Water LLC</i> by (signature) <i>[Signature]</i>																													
INSTRUCTIONS: Use typewriter or ball point pen. Please press firmly and print clearly. Please fill in blanks, underline or circle the correct answers. Send top three copies to Kansas Department of Health and Environment, Bureau of Water, Geology Section, 1000 SW Jackson St., Ste. 420, Topeka, Kansas 66612-1367. Telephone: 785/296-5522. Send one to Water Well Owner and retain one for your records.																														