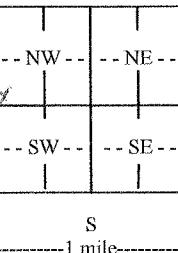
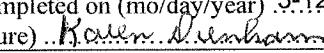


## WATER WELL RECORD

## Form WWC-5

Division of Water Resources App. No. \_\_\_\_\_

<b>1 LOCATION OF WATER WELL:</b> County: Gray		Fraction $\frac{1}{4}$ SW $\frac{1}{4}$ SW $\frac{1}{4}$ NW $\frac{1}{4}$	Section Number 34	Township No. T 27 S	Range Number R 27 <input type="checkbox"/> E <input type="checkbox"/> W																				
Street/Rural Address of Well Location; if unknown, distance & direction from nearest town or intersection: If at owner's address, check here <input checked="" type="checkbox"/> .																									
<b>2 WATER WELL OWNER:</b> Todd Hamilton RR#, Street Address, Box #: 24506 22 Road City, State, ZIP Code : Ensign, Kansas 67841																									
<b>3 LOCATE WELL WITH AN "X" IN SECTION BOX:</b>   W-----S  -----1 mile-----		<b>4 DEPTH OF COMPLETED WELL</b> 233 ft. Depth(s) Groundwater Encountered (1) 212 ft. (2) 225 ft. (3) ft. WELL'S STATIC WATER LEVEL 210 ft. below land surface measured on mo/day/yr. Pump test data: Well water was ..... ft. after ..... hours pumping ..... gpm EST. YIELD 25 gpm. Well water was ..... ft. after ..... hours pumping ..... gpm Bore Hole Diameter ..... in. to ..... ft. and ..... in. to ..... ft. <b>WELL WATER TO BE USED AS:</b> <input type="checkbox"/> Public water supply <input type="checkbox"/> Geothermal <input type="checkbox"/> Injection well <input checked="" type="checkbox"/> Domestic <input type="checkbox"/> Feedlot <input type="checkbox"/> Oil field water supply <input type="checkbox"/> Dewatering <input type="checkbox"/> Other (Specify below) <input type="checkbox"/> Irrigation <input type="checkbox"/> Industrial <input type="checkbox"/> Domestic-lawn & garden <input type="checkbox"/> Monitoring well ..... Was a chemical/bacteriological sample submitted to Department? <input type="checkbox"/> Yes <input checked="" type="checkbox"/> No If yes, mo/day/yr sample was submitted..... Water well disinfected? <input checked="" type="checkbox"/> Yes <input type="checkbox"/> No																							
<b>5 TYPE OF CASING USED:</b> <input type="checkbox"/> Steel <input checked="" type="checkbox"/> PVC <input type="checkbox"/> Other ..... <b>CASING JOINTS:</b> <input type="checkbox"/> Glued <input type="checkbox"/> Clamped <input type="checkbox"/> Welded <input type="checkbox"/> Threaded Casing diameter .5 in. to 213 ft., Diameter ..... in. to ..... ft., Diameter ..... in. to ..... ft. Casing height above land surface 12 in., Weight ..... lbs./ft., Wall thickness or gauge No. SDR26 <b>TYPE OF SCREEN OR PERFORATION MATERIAL:</b> <table style="width: 100%;"><tr><td><input type="checkbox"/> Steel</td><td><input type="checkbox"/> Stainless Steel</td><td><input checked="" type="checkbox"/> PVC</td><td><input type="checkbox"/> Other (Specify) .....</td></tr><tr><td><input type="checkbox"/> Brass</td><td><input type="checkbox"/> Galvanized Steel</td><td><input type="checkbox"/> None used (open hole)</td><td></td></tr></table> <b>SCREEN OR PERFORATION OPENINGS ARE:</b> <table style="width: 100%;"><tr><td><input type="checkbox"/> Continuous slot</td><td><input type="checkbox"/> Mill slot</td><td><input type="checkbox"/> Gauze wrapped</td><td><input type="checkbox"/> Torch cut</td><td><input type="checkbox"/> Drilled holes</td><td><input type="checkbox"/> None (open hole)</td></tr><tr><td><input type="checkbox"/> Louvered shutter</td><td><input type="checkbox"/> Key punched</td><td><input type="checkbox"/> Wire wrapped</td><td><input checked="" type="checkbox"/> Saw cut</td><td><input type="checkbox"/> Other (specify) .....</td><td></td></tr></table> <b>SCREEN-PERFORATED INTERVALS:</b> From 213 ft. to 233 ft., From ..... ft. to ..... ft. From ..... ft. to ..... ft., From ..... ft. to ..... ft. <b>GRAVEL PACK INTERVALS:</b> From 20 ft. to 233 ft.
<b>6 GROUT MATERIAL:</b> <input checked="" type="checkbox"/> Neat cement <input type="checkbox"/> Cement grout <input checked="" type="checkbox"/> Bentonite <input type="checkbox"/> Other ..... Grout Intervals: From 20 ft. to 16 Ben ft., From 16 ft. to 0 cement ft., From ..... ft. to ..... ft. What is the nearest source of possible contamination: <table style="width: 100%;"><tr><td><input type="checkbox"/> Septic tank</td><td><input type="checkbox"/> Lateral lines</td><td><input type="checkbox"/> Pit privy</td><td><input type="checkbox"/> Livestock pens</td><td><input type="checkbox"/> Insecticide storage</td><td><input type="checkbox"/> Other (specify below)</td></tr><tr><td><input type="checkbox"/> Sewer lines</td><td><input type="checkbox"/> Cesspool</td><td><input type="checkbox"/> Sewage lagoon</td><td><input type="checkbox"/> Fuel storage</td><td><input type="checkbox"/> Abandoned water well</td><td></td></tr><tr><td><input type="checkbox"/> Watertight sewer lines</td><td><input type="checkbox"/> Seepage pit</td><td><input type="checkbox"/> Feedyard</td><td><input type="checkbox"/> Fertilizer storage</td><td><input type="checkbox"/> Oil well/gas well</td><td></td></tr>
FROM	TO	LITHOLOGIC LOG	FROM	TO	LITHO. LOG (cont.) or PLUGGING INTERVALS																				
0	15	Topsoil, clay & lime	195	210	Sand																				
15	30	Clay, sand	210	231	Sand & gravel																				
30	75	Clay, lime & sand	231	234	Lime																				
75	90	Fine sand & clay																							
90	105	Sand & clay																							
105	135	Fine sand																							
135	150	Clay & fine sand																							
150	170	Clay, lime																							
170	180	Sand																							
180	195	Sand, coarse																							
<b>7 CONTRACTOR'S OR LANDOWNER'S CERTIFICATION:</b> This water well was <input checked="" type="checkbox"/> constructed, <input type="checkbox"/> reconstructed, or <input type="checkbox"/> plugged under my jurisdiction and was completed on (mo/day/year) 3-5-12 and this record is true to the best of my knowledge and belief. Kansas Water Well Contractor's License No 23. This Water Well Record was completed on (mo/day/year) 3-12-12 under the business name of Dunham Drilling Inc. by (signature) 																									
<b>INSTRUCTIONS:</b> Use typewriter or ball point pen. <b>PLEASE PRESS FIRMLY</b> and <b>PRINT</b> clearly. Please fill in blanks and check the correct answers. Send three copies (white, blue, pink) to Kansas Department of Health and Environment, Bureau of Water, Geology Section, 1000 SW Jackson St., Suite 420, Topeka, Kansas 66612-1367. Telephone 785-296-5524. Send one copy to WATER WELL OWNER and retain one for your records. Include fee of \$5.00 for each <u>constructed</u> well. Visit us at <a href="http://www.kdheks.gov/waterwell/index.html">http://www.kdheks.gov/waterwell/index.html</a> .																									