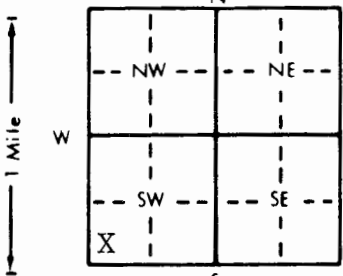


1 LOCATION OF WATER WELL: County: <u>Gray</u>		Fraction <u>Near Center of</u>	Section Number <u>25</u>	Township Number <u>T 27 S</u>	Range Number <u>R 27 E/W</u>
Distance and direction from nearest town or city street address of well if located within city? <u>From NW corner of Ensign - 1/2 Mile North, 1/4 Mile East & 1/8th Mile North (West domestic well)</u>					
2 WATER WELL OWNER: <u>Slocum Trust c/o Howard Thompson</u> RR#, St. Address, Box # : <u>Route 1 - Box 181</u> City, State, ZIP Code : <u>Rogersville, Missouri 65742</u> Board of Agriculture, Division of Water Resources Application Number: _____					
3 LOCATE WELL'S LOCATION WITH AN "X" IN SECTION BOX: <div style="text-align: center;"></div>		4 DEPTH OF COMPLETED WELL: <u>150</u> ft. ELEVATION: _____ Depth(s) Groundwater Encountered 1. _____ ft. 2. _____ ft. 3. _____ ft. WELL'S STATIC WATER LEVEL <u>dry</u> ft. below land surface measured on mo/day/yr <u>11-9-94</u> Pump test data: Well water was _____ ft. after _____ hours pumping _____ gpm Est. Yield _____ gpm: Well water was _____ ft. after _____ hours pumping _____ gpm Bore Hole Diameter: _____ in. to _____ ft., and _____ in. to _____ ft. WELL WATER TO BE USED AS: <input checked="" type="radio"/> 1 Domestic 3 Feedlot 6 Oil field water supply 9 Dewatering 12 Other (Specify below) 2 Irrigation 4 Industrial 7 Lawn and garden only 10 Monitoring well Was a chemical/bacteriological sample submitted to Department? Yes _____ No <u>5</u> If yes, mo/day/yr sample was submitted _____ Water Well Disinfected? Yes <u>X</u> No _____			
5 TYPE OF BLANK CASING USED: <input checked="" type="radio"/> 1 Steel 3 RMP (SR) 5 Wrought iron 8 Concrete tile CASING JOINTS: Glued _____ Clamped _____ 2 PVC 4 ABS 6 Asbestos-Cement 9 Other (specify below) Welded _____ 7 Fiberglass Threaded _____ Blank casing diameter <u>4</u> in. to _____ ft., Dia _____ in. to _____ ft., Dia _____ in. to _____ ft. Casing height <u>above</u> land surface <u>42"</u> in., weight _____ lbs./ft. Wall thickness or gauge No. _____ TYPE OF SCREEN OR PERFORATION MATERIAL: 1 Steel 3 Stainless steel 5 Fiberglass 8 RMP (SR) 10 Asbestos-cement 2 Brass 4 Galvanized steel 6 Concrete tile 9 ABS 11 Other (specify) <u>NA</u> 12 None used (open hole) SCREEN OR PERFORATION OPENINGS ARE: 1 Continuous slot 3 Mill slot 5 Gauzed wrapped 8 Saw cut 11 None (open hole) 2 Louvered shutter 4 Key punched 6 Wire wrapped 9 Drilled holes 7 Torch cut 10 Other (specify) <u>NA</u> SCREEN-PERFORATED INTERVALS: From <u>NA</u> ft. to <u>NA</u> ft., From _____ ft. to _____ ft. From _____ ft. to _____ ft., From _____ ft. to _____ ft. GRAVEL PACK INTERVALS: From _____ ft. to _____ ft., From _____ ft. to _____ ft. From _____ ft. to _____ ft., From _____ ft. to _____ ft.					
6 GROUT MATERIAL: 1 Neat cement 2 <u>Cement grout</u> 3 Bentonite 4 Other _____ Grout Intervals: From <u>6</u> ft. to <u>3</u> ft., From _____ ft. to _____ ft., From _____ ft. to _____ ft. What is the nearest source of possible contamination: 1 Septic tank 4 Lateral lines 7 Pit privy 10 Livestock pens 14 Abandoned water well 2 Sewer lines 5 Cess pool 8 Sewage lagoon 11 Fuel storage 15 Oil well/Gas well 3 Watertight sewer lines 6 Seepage pit 9 Feedyard 12 Fertilizer storage 16 Other (specify below) <u>None</u> 13 Insecticide storage Direction from well? _____ How many feet? _____					
FROM		TO		LITHOLOGIC LOG	FROM TO PLUGGING INTERVALS
				<u>6</u>	<u>0 3</u> <u>3 150</u> <u>Top soil</u> <u>Cement Grout</u>
7 CONTRACTOR'S OR LANDOWNER'S CERTIFICATION: This water well was (1) constructed, (2) reconstructed, or <input checked="" type="radio"/> (3) plugged under my jurisdiction and was completed on (mo/day/year) <u>11-9-94</u> and this record is true to the best of my knowledge and belief. Kansas Water Well Contractor's License No. <u>208</u> This Water Well Record was completed on (mo/day/yr) <u>11-25-94</u> under the business name of <u>Minter-Wilson Drilling Co., Inc.</u> by (signature) <u>Nora Keller</u>					