

WATER WELL RECORD

Form WWC-5

KSA 82a-1212


1 LOCATION OF WATER WELL:		Fraction 1/4	Near Center 1/4 NW 1/4	Section Number 4	Township Number T 27 S	Range Number R 28 EW
---------------------------	--	-----------------	---------------------------	---------------------	---------------------------	-------------------------

Distance and direction from nearest town or city street address of well if located within city?

From south side of Cimarron - 5 1/4 miles south, 2 miles west, 3,960 ft. north & 4,250 ft. west

2 WATER WELL OWNER:		Bob Vath			Board of Agriculture, Division of Water Resources	
RR#, St. Address, Box #:		18003 - #14 Road			Application Number: 19,229	
City, State, ZIP Code:		Cimarron, Kansas 67835				

3 LOCATE WELL'S LOCATION WITH AN "X" IN SECTION BOX:		4 DEPTH OF COMPLETED WELL 240 ft. ELEVATION:		
--	--	--	--	--

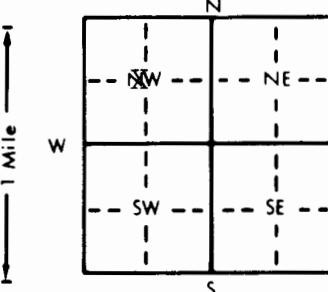

Depth(s) Groundwater Encountered 1. ft. 2. ft. 3. ft.

WELL'S STATIC WATER LEVEL 121 ft. below land surface measured on mo/day/yr 4-15-96

Pump test data: Well water was ft. after hours pumping gpm

Est. Yield gpm: Well water was ft. after hours pumping gpm

Bore Hole Diameter 30 in. to 240 ft. and in. to ft.

WELL WATER TO BE USED AS: 5 Public water supply 8 Air conditioning 11 Injection well

1 Domestic 3 Feedlot 6 Oil field water supply 9 Dewatering 12 Other (Specify below)

2 Irrigation 4 Industrial 7 Lawn and garden only 10 Monitoring well

Was a chemical/bacteriological sample submitted to Department? Yes X; If yes, mo/day/yr sample was submitted

Water Well Disinfected? Yes X No X

5 TYPE OF BLANK CASING USED:		5 Wrought iron	8 Concrete tile	CASING JOINTS: Glued	Clamped
------------------------------	--	----------------	-----------------	----------------------------	---------------

1 Steel 3 RMP (SR)
 2 PVC 4 ABS

6 Asbestos-Cement
7 Fiberglass

9 Other (specify below)
Welded X

Threaded.

Blank casing diameter 16 in. to 170 ft., Dia in. to ft., Dia in. to ft.

Casing height above land surface 12 in., weight 42.05 lbs./ft. Wall thickness or gauge No. 250

TYPE OF SCREEN OR PERFORATION MATERIAL:

1 Steel 3 Stainless steel
 2 Brass 4 Galvanized steel

5 Fiberglass
6 Concrete tile

7 PVC
10 Asbestos-cement

11 Other (specify)

12 None used (open hole)

SCREEN OR PERFORATION OPENINGS ARE:

1 Continuous slot 3 Mill slot
 2 Louvered shutter 4 Key punched

5 Gauzed wrapped
6 Wire wrapped
7 Torch cut

8 Saw cut
9 Drilled holes
10 Other (specify)

11 None (open hole)

SCREEN-PERFORATED INTERVALS: From 170 ft. to 240 ft., From ft. to ft.

From ft. to ft., From ft. to ft.

GRAVEL PACK INTERVALS: From 20 ft. to 240 ft., From ft. to ft.

From ft. to ft., From ft. to ft.

6 GROUT MATERIAL:		1 Neat cement	2 Cement grout	3 Bentonite	4 Other
-------------------	--	---------------	----------------	-------------	---------------

Grout Intervals: From 0 ft. to 20 ft., From ft. to ft., From ft. to ft., From ft. to ft.

What is the nearest source of possible contamination:

1 Septic tank 4 Lateral lines
 2 Sewer lines 5 Cess pool
 3 Watertight sewer lines 6 Seepage pit

7 Pit privy
8 Sewage lagoon
9 Feedyard

10 Livestock pens
11 Fuel storage
12 Fertilizer storage
13 Insecticide storage

14 Abandoned water well

15 Oil well/Gas well

16 Other (specify below)

Direction from well? southeast How many feet? 10 ft. south-290 ft. east

FROM	TO	LITHOLOGIC LOG	FROM	TO	PLUGGING INTERVALS
------	----	----------------	------	----	--------------------

See attached log

7 CONTRACTOR'S OR LANDOWNER'S CERTIFICATION: This water well was 1) constructed, 2) reconstructed, or 3) plugged under my jurisdiction and was completed on (mo/day/year) 4-15-96 and this record is true to the best of my knowledge and belief. Kansas Water Well Contractor's License No. 208 This Water Well Record was completed on (mo/day/yr) 4-25-96 under the business name of Minter-Wilson Drilling Co., Inc. by (signature) <i>Nora Kellee</i>					
--	--	--	--	--	--