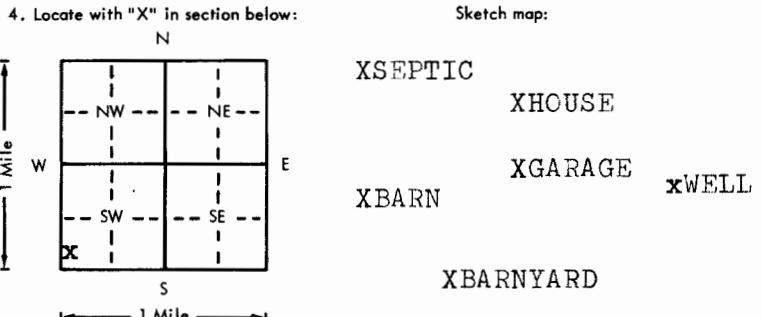
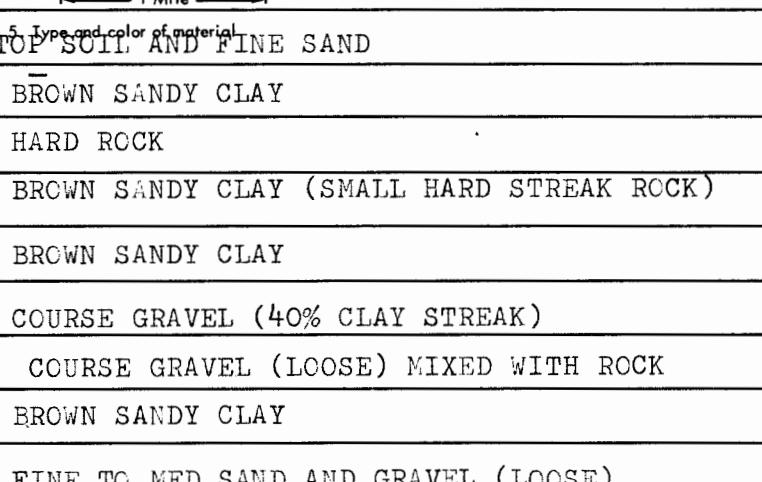


USE TYPEWRITER OR BALL
POINT PEN-PRESS FIRMLY,
PRINT CLEARLY.

WATER WELL RECORD
KSA 82a-1201-1215

Kansas Department of Health and
Environment-Division of Environment
(Water well Contractors)
Topeka, Kansas 66620

1. Location of well:	County GRAY CO.	Fraction SW 1/4 SW 1/4 SW 1/4	Section number 1	Township number T 27 S	Range number R 28	
2. Distance and direction from nearest town or city: 6 M. S. OF CIMARRON AND 1/2 M. E. Street address of well location if in city:	3. Owner of well: RICHARD STRAWN R.R. or street: CIMARRON, KS. City, state, zip code: 67					
4. Locate with "X" in section below: 	Sketch map: 					
5. Type and color of material TOP SOIL AND FINE SAND			From 0	To 7	6. Bore hole dia. 9 1/2 in. Completion date 1/25/76 Well depth 260 ft.	
BROWN SANDY CLAY			7	45	7. Cable tool <input checked="" type="checkbox"/> Rotary <input type="checkbox"/> Driven <input type="checkbox"/> Dug <input type="checkbox"/> Hollow rod <input checked="" type="checkbox"/> Jetted <input type="checkbox"/> Bored <input type="checkbox"/> Reverse rotary	
HARD ROCK			45	47	8. Use: <input checked="" type="checkbox"/> Domestic <input type="checkbox"/> Public supply <input type="checkbox"/> Industry <input type="checkbox"/> Irrigation <input type="checkbox"/> Air conditioning <input type="checkbox"/> Stock <input type="checkbox"/> Lawn <input type="checkbox"/> Oil field water <input type="checkbox"/> Other	
BROWN SANDY CLAY (SMALL HARD STREAK ROCK)			47	60	9. Casing: Material <input checked="" type="checkbox"/> PITS <input type="checkbox"/> Threaded <input type="checkbox"/> Welded <input checked="" type="checkbox"/> GT <input type="checkbox"/> Surface <input type="checkbox"/> 12 in. RMP <input type="checkbox"/> PVC <input checked="" type="checkbox"/> Weight 190 lbs./ft. Dia. 5 in. to 180 ft. depth Wall Thickness: inches or Dia. 170 in. to 250 ft. depth gage No. SCH 40	
BROWN SANDY CLAY			60	72	10. Screen: Manufacturer's name <input checked="" type="checkbox"/> JET STREAM	
COURSE GRAVEL (40% CLAY STREAK)			72	80	Type <input checked="" type="checkbox"/> PVC <input type="checkbox"/> Dia. 5"	
COURSE GRAVEL (LOOSE) MIXED WITH ROCK			80	105	Slot <input checked="" type="checkbox"/> <input type="checkbox"/> Length 30 ft. Set between 150 ft. and 170 ft. 250 ft. and 260 ft.	
BROWN SANDY CLAY			105	120	Gravel pack? <input checked="" type="checkbox"/> Size range of material 1/4" to 1/8	
FINE TO MED SAND AND GRAVEL (LOOSE)			120	126	11. Static water level: 88 ft. below land surface Date 1/20/76	
BROWN SANDY CLAY (FEW SMALL HARD STREAKS)			126	135	12. Pumping level below land surfaces: ft. after hrs. pumping g.p.m. ft. after hrs. pumping g.p.m.	
HARD ROCK			135	137	Estimated maximum yield g.p.m.	
FINE TO MED SAND AND GRAVEL (LOOSE)			137	147	13. Water sample submitted: mo./day/yr. Yes <input checked="" type="checkbox"/> No Date	
CLAY			147	149	14. Well head completion: <input checked="" type="checkbox"/> Pitless adapter 12 inches above grade	
FINE TO MED SAND AND GRAVEL (LOOSE)			149	168	15. Well grouted? <input checked="" type="checkbox"/> With: <input type="checkbox"/> Neat cement <input type="checkbox"/> Bentonite <input checked="" type="checkbox"/> Concrete Depth: From 5 ft. to 15 ft.	
BROWN SANDY AND WHITE CLAY			168	190	16. Nearest source of possible contamination: ft. 50 Direction N Type GARAGE	
FINE TO MED SAND AND FINE SAND			190	195	Well disinfected upon completion? <input checked="" type="checkbox"/> Yes <input type="checkbox"/> No	
BROWN SANDY CLAY			195	290	17. Pump: Not installed Manufacturer's name GOULDS Model number 25EL HP 1 1/2 Volts 230	
BROWN SANDY CLAY (STREAK FINE SAND)			290	295	Length of drop pipe 147 ft. capacity 25 g.p.m.	
FINE TO MED SAND AND FINE SAND (if needed)			250	260	Type: <input checked="" type="checkbox"/> Submersible <input type="checkbox"/> Turbine <input type="checkbox"/> Jet <input type="checkbox"/> Reciprocating <input type="checkbox"/> Centrifugal <input type="checkbox"/> Other	
18. Elevation:	19. Remarks: WITH BROWN AND WHITE ROCK					20. Water well contractor's certification: This well was drilled under my jurisdiction and this report is true to the best of my knowledge and belief. JONAGAN DRILLING CO 172 Business name <input type="checkbox"/> Address GARDEN CITY, KS. License No. <input type="checkbox"/> Signed MARTHA L. JONAGAN Date 2/10/76 Authorized representative <input type="checkbox"/>
Topography: <input type="checkbox"/> Hill <input type="checkbox"/> Slope <input type="checkbox"/> Upland <input checked="" type="checkbox"/> Valley						