

WATER WELL RECORD

Form WWC-5

KSA 82a-1212


1 LOCATION OF WATER WELL:	Fraction County: Gray	SW $\frac{1}{4}$ NE $\frac{1}{4}$ NE $\frac{1}{4}$	Section Number 5	Township Number T 27 S	Range Number R 28 E/W
---------------------------	--------------------------	--	---------------------	---------------------------	--------------------------

Distance and direction from nearest town or city street address of well if located within city?

From Cimarron, Ks. - 4 miles South on highway 23 and 4 miles West

2 WATER WELL OWNER:	Cora Byers	Board of Agriculture, Division of Water Resources
RR#, St. Address, Box #:	Cimarron, Kansas 67835	Application Number:

3 LOCATE WELL'S LOCATION WITH AN "X" IN SECTION BOX:	4 DEPTH OF COMPLETED WELL ft. ELEVATION:
--	--

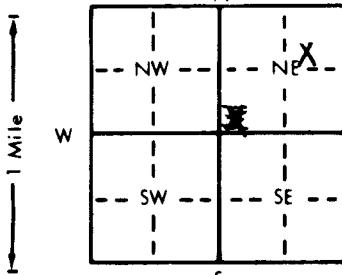

3 LOCATE WELL'S LOCATION WITH AN "X" IN SECTION BOX:	4 DEPTH OF COMPLETED WELL ft. ELEVATION:
--	--

Depth(s) Groundwater Encountered 1. ft. 2. ft. 3. ft.

WELL'S STATIC WATER LEVEL 104 ft. below land surface measured on mo/day/yr October 1, 1984

Pump test data: Well water was ft. after hours pumping gpm

Est. Yield 35 gpm: Well water was ft. after hours pumping gpm

Bore Hole Diameter 8 in. to 257 ft. and in. to ft.

WELL WATER TO BE USED AS: 5 Public water supply 8 Air conditioning 11 Injection well

1 Domestic 3 Feedlot 6 Oil field water supply 9 Dewatering 12 Other (Specify below)

2 Irrigation 4 Industrial 7 Lawn and garden only 10 Observation well

Was a chemical/bacteriological sample submitted to Department? Yes No XXX. If yes, mo/day/yr sample was submitted

Water Well Disinfected? Yes XXXX No

5 TYPE OF BLANK CASING USED:	5 Wrought iron	8 Concrete tile	CASING JOINTS: Glued Clamped
------------------------------	----------------	-----------------	--

1 Steel 3 RMP (SR) 6 Asbestos-Cement 9 Other (specify below) Welded

2 PVC 4 ABS 7 Fiberglass Threaded

Blank casing diameter 5 in. to 257 ft., Dia in. to ft., Dia in. to ft.

Casing height above land surface 12 in., weight 200 psi lbs./ft. Wall thickness or gauge No. SDR 21

TYPE OF SCREEN OR PERFORATION MATERIAL:

1 Steel 3 Stainless steel 5 Fiberglass 7 PVC 10 Asbestos-cement

2 Brass 4 Galvanized steel 6 Concrete tile 8 RMP (SR) 11 Other (specify)

SCREEN OR PERFORATION OPENINGS ARE: 5 Gauzed wrapped 9 ABS 12 None used (open hole)

1 Continuous slot 3 Mill slot 6 Wire wrapped 10 Saw cut 11 None (open hole)

2 Louvered shutter 4 Key punched 7 Torch cut 9 Drilled holes

SCREEN-PERFORATED INTERVALS: From 232 ft. to 252 ft., From ft. to ft.

From ft. to ft., From ft. to ft.

GRAVEL PACK INTERVALS: From 22 ft. to 257 ft., From ft. to ft.

From ft. to ft., From ft. to ft.

6 GROUT MATERIAL:	1 Neat cement	2 Cement grout	3 Bentonite	4 Other
-------------------	---------------	----------------	-------------	-------------------

Grout Intervals: From 5 ft. to 22 ft., From ft. to ft., From ft. to ft.

What is the nearest source of possible contamination:

1 Septic tank 4 Lateral lines 7 Pit privy 10 Livestock pens 14 Abandoned water well

2 Sewer lines 5 Cess pool 8 Sewage lagoon 11 Fuel storage 15 Oil well/Gas well

3 Watertight sewer lines 6 Seepage pit 9 Feedyard 12 Fertilizer storage 16 Other (specify below)

Direction from well? South How many feet? 20

FROM	TO	LITHOLOGIC LOG	FROM	TO	LITHOLOGIC LOG
------	----	----------------	------	----	----------------

0	15	Top soil & clay			
15	30	Clay			
30	45	Clay & fine sand			
45	75	Clay & fine sand			
75	90	Fine to medium sand			
90	105	Medium to coarse sand			
105	120	Medium to coarse sand & clay			
120	135	Clay & fine sand in layers			
135	150	" " " "			
150	165	Clay & fine to medium sand *5 ft.)			
165	180	Medium to coarse sand & clay (2 ft.)			
180	195	Clay rock layers & fine sand			
195	210	Medium to fine sand			
210	240	Medium to coarse sand			
240	257	Medium to coarse sand, rock & clay			

7 CONTRACTOR'S OR LANDOWNER'S CERTIFICATION: This water well was (1) constructed, (2) reconstructed, or (3) plugged under my jurisdiction and was completed on (mo/day/year) October 2, 1984 and this record is true to the best of my knowledge and belief. Kansas

Water Well Contractor's License No. 179 This Water Well Record was completed on (mo/day/yr) October 10, 1984 under the business name of Joe's Well Service, Inc. Cimarron, Ks. by (signature) *John C. Clark*

INSTRUCTIONS: Use typewriter or ball point pen, PLEASE PRESS FIRMLY and PRINT clearly. Please fill in blanks, underline or circle the correct answers. Send top three copies to Kansas Department of Health and Environment, Division of Environment, Environmental Geology Section, Topeka, KS 66620. Send one to WATER WELL OWNER and retain one for your records.