

USE TYPEWRITER OR BALL
POINT PEN-PRESS FIRMLY,
PRINT CLEARLY.

WATER WELL RECORD
KSA 82a-1201-1215

Kansas Department of Health and
Environment-Division of Environment
(Water well Contractors)
Topeka, Kansas 66620

1. Location of well:	County	Fraction	Section number	Township number	Range number		
	GRAY	NE 1/4 SW 1/4 NE 1/4	10	T 27 S	R 28 NW		
2. Distance and direction from nearest town or city: Cimmaron 1 1/2 west 1/4 south Street address of well location if in city:	5 1/4 south of		3. Owner of well: Don Renick R.R. or street: (27) City, state, zip code: Ingalls, Ks. 67853				
4. Locate with "X" in section below:	Sketch map:		6. Bore hole dia. 26 in. Completion date 4-20-76 Well depth 251 ft.				
			7. <input type="checkbox"/> Cable tool <input type="checkbox"/> Rotary <input type="checkbox"/> Driven <input type="checkbox"/> Dug <input type="checkbox"/> Hollow rod <input type="checkbox"/> Jetted <input type="checkbox"/> Bored <input checked="" type="checkbox"/> Reverse rotary 8. Use: <input type="checkbox"/> Domestic <input type="checkbox"/> Public supply <input type="checkbox"/> Industry <input checked="" type="checkbox"/> Irrigation <input type="checkbox"/> Air conditioning <input type="checkbox"/> Stock <input type="checkbox"/> Lawn <input type="checkbox"/> Oil field water <input type="checkbox"/> Other 9. Casing: Material <input checked="" type="checkbox"/> steel Height: Above or below <input type="checkbox"/> Threaded <input type="checkbox"/> Welded <input checked="" type="checkbox"/> Surface 12 in. RMP <input type="checkbox"/> PVC <input type="checkbox"/> Weight 36.87 lbs./ft. Dia 16 in. to 255 depth Wall Thickness: inches or Dia. in. to ft. depth gage No. _____				
5. Type and color of material	From	To	10. Screen: Manufacturer's name Johnson Division Type Galv Dia. 16" Slot/gauze 100 Length 201 Set between 210 ft. and 230 ft. Port. 110-210 ft. and 230-254 ft. Gravel pack? <input checked="" type="checkbox"/> Yes Size range of material 16" Down				
			11. Static water level: mo./day/yr. 56 ft. below land surface Date 3-9-76				
			12. Pumping level below land surfaces: 112 ft. after 3 hrs. pumping 850 g.p.m. ft. after hrs. pumping g.p.m. Estimated maximum yield 850 g.p.m.				
			13. Water sample submitted: mo./day/yr. Yes <input checked="" type="checkbox"/> No Date				
			14. Well head completion: 12 Pitless adapter <input checked="" type="checkbox"/> Yes Inches above grade				
			15. Well grouted? <input type="checkbox"/> With: <input type="checkbox"/> Neat cement <input checked="" type="checkbox"/> Bentonite <input type="checkbox"/> Concrete Depth: From 0 ft. to 10 ft. N/A				
			16. Nearest source of possible contamination: ft. Direction Type Well disinfected upon completion? <input type="checkbox"/> Yes <input checked="" type="checkbox"/> No				
			17. Pump: Not installed Manufacturer's name Goulds US Pumps Model number 12 HHD HP 75 Volts Length of drop pipe 160 ft. capacity 1060 g.m. Type: <input type="checkbox"/> Submersible <input checked="" type="checkbox"/> Turbine <input type="checkbox"/> Jet <input type="checkbox"/> Reciprocating <input type="checkbox"/> Centrifugal <input type="checkbox"/> Other				
(Use a second sheet if needed)			18. Elevation: Topography: <input type="checkbox"/> Hill <input checked="" type="checkbox"/> Slope <input type="checkbox"/> Upland <input type="checkbox"/> Valley			19. Remarks: Drilling done by Central Well & Pump Pratt, Ks.	20. Water well contractor's certification: This well was drilled under my jurisdiction and this report is true to the best of my knowledge and belief. Minter Wilson Drilling 208 Business name P.O. Box A Garden City, Address Signed <i>M. Minter Wilson</i> Date 8-12-76 Authorized representative

USE TYPEWRITER OR BALL
POINT PEN-PRESS FIRMLY,
PRINT CLEARLY.


The Professionals **MINTER-WILSON DRILLING CO.** INCORPORATED Complete Installation and Repairing

Irrigation
and Domestic
Water Systems
28

Phone 276-8269 • P.O. Box 493 • GARDEN CITY, KANSAS 67846

1. Location of well:	County GRAY
2. Distance and direction from nearest town or city: Cimmaron $\frac{1}{4}$ mile west $\frac{1}{4}$ mile south	28 Street address of well location if in city:

4. Locate with "X" in section below:

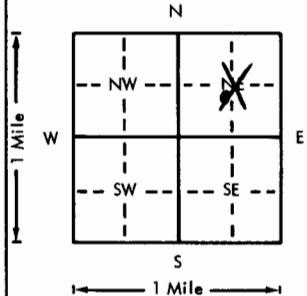

5. Type and color of material

0	7	Fine to med. sand
7	47	Fine to med. sand & clay
47	80	Fine to med. sand & gravel, small streaks of coarse gravel
80	125	Fine to med. sand & gravel (loose)
125	139	Brown clay & white rock, 29% gravel
139	165	Fine to med. sand & gravel (loose)
165	174	Fine to med. sand & gravel, 15% clay (loose)
174	187	Brown clay, streaks of gravel 30%
187	200	Brown, gray & yellow clay with white rock (hard)

TD - 190'

(Use a second sheet if needed)

18. Elevation:	19. Remarks: Drilling done by Central Well & Pump Pratt, Ks.	20. Water well contractor's certification: This well was drilled under my jurisdiction and this report is true to the best of my knowledge and belief. Minter Wilson Drilling 208 Business name P.O. Box A Garden City, Ks. Address Signed <i>McLane</i> Date <i>8-12-76</i> Authorized representative
<input type="checkbox"/> Submersible <input type="checkbox"/> Jet <input type="checkbox"/> Centrifugal		<input type="checkbox"/> Turbine <input type="checkbox"/> Reciprocating <input type="checkbox"/> Other
<input type="checkbox"/> Hill <input checked="" type="checkbox"/> Slope <input type="checkbox"/> Upland <input type="checkbox"/> Valley		<input type="checkbox"/> KS <input type="checkbox"/> NE <input type="checkbox"/> SE <input type="checkbox"/> SW