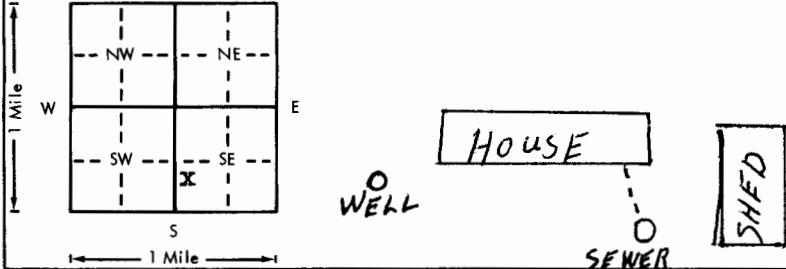


USE TYPEWRITER OR BALL
POINT PEN-PRESS FIRMLY,
PRINT CLEARLY.

WATER WELL RECORD
KSA 82a-1201-1215

Kansas Department of Health and
Environment-Division of Environment
(Water well Contractors)
Topeka, Kansas 66620

1. Location of well:	County	Fraction <i>NW NW SW 1/4 SW 1/4</i>	Section number	Township number	Range number
	Gray		#18	T #27	S R #28 W <i>SW</i>
2. Distance and direction from nearest town or city:	8 miles south, <i>4 1/2 miles west of Cimarron, Ks.</i>		3. Owner of well:	John B. Unruh	
Street address or well location if in city:			R.R. or street:		
4. Locate with "X" in section below:	Sketch map:		6. Bore hole dia. <u>8</u> in. Completion date <u>4-6-76</u> Well depth <u>245</u> ft.		
			7. <input checked="" type="checkbox"/> Cable tool <input checked="" type="checkbox"/> Rotary <input type="checkbox"/> Driven <input type="checkbox"/> Dug <input type="checkbox"/> Hollow rod <input type="checkbox"/> Jetted <input type="checkbox"/> Bored <input type="checkbox"/> Reverse rotary		
5. Type and color of material	From	To	8. Use: <input checked="" type="checkbox"/> Domestic <input type="checkbox"/> Public supply <input type="checkbox"/> Industry <input type="checkbox"/> Irrigation <input type="checkbox"/> Air conditioning <input type="checkbox"/> Stock <input type="checkbox"/> Lawn <input type="checkbox"/> Oil field water <input type="checkbox"/> Other		
Top soil & clay	0	15	9. Casing: Material <u>RMP</u> Height: Above <u>XX</u> in. Threaded <input type="checkbox"/> Welded <input type="checkbox"/> Surface <u>12</u> in. <u>RMP</u> <input checked="" type="checkbox"/> PVC <input type="checkbox"/> Weight <input type="checkbox"/> lbs./ft. Dia. <u>5</u> in. to <u>245</u> ft. depth Wall thickness: inches or Dia. <input type="checkbox"/> in. to <input type="checkbox"/> ft. depth gage No. <u>250</u>		
Clay	15	45	10. Screen: Manufacturer's name <u>Sunflower</u> Type <u>RMP</u> Dia. <u>5@</u> Slot size <u>1/8"</u> Length <u>20</u> ft. Set between <u>220</u> ft. and <u>240</u> ft. ft. and <u>1</u> ft. Gravel pack? <u>yes</u> Size range of material <u>4</u>		
Clay & fine sand	45	60	11. Static water level: <u>78</u> ft. below land surface Date <u>4-6-76</u> mo./day/yr.		
Fine sand	60	75	12. Pumping level below land surfaces: <u>80</u> ft. after <u>1</u> hrs. pumping <u>50</u> g.p.m. <input type="checkbox"/> ft. after <input type="checkbox"/> hrs. pumping <input type="checkbox"/> g.p.m. Estimated maximum yield <u>80</u> g.p.m.		
Fine to medium sand	75	90	13. Water sample submitted: <input type="checkbox"/> Yes <input checked="" type="checkbox"/> No Date <input type="checkbox"/>		
Medium to coarse sand	90	105	14. Well head completion: <input checked="" type="checkbox"/> Pitless adapter <u>12</u> inches above grade		
" " " "	105	120	15. Well grouted? <u>yes</u> With: <input checked="" type="checkbox"/> Neat cement <input type="checkbox"/> Bentonite <input type="checkbox"/> Concrete Depth: From <u>5</u> ft. to <u>15</u> ft.		
Coarse sand & clay	120	135	16. Nearest source of possible contamination: ft. <u>70</u> Direction <u>West</u> Type <u>Sewer</u>		
Clay	135	150	Well disinfected upon completion? <input checked="" type="checkbox"/> Yes <input type="checkbox"/> No		
Clay layers & fine sand	150	165	17. Pump: <input type="checkbox"/> Not installed Manufacturer's name <u>Flint & Walling</u> Model number <u>10BK9</u> HP <u>1</u> Volts <u>230</u> Length of drop pipe <u>147</u> ft. capacity <u>19</u> g.p.m.		
Fine to medium sand & clay	165	180	Type: <input checked="" type="checkbox"/> Submersible <input type="checkbox"/> Turbine <input type="checkbox"/> Jet <input type="checkbox"/> Reciprocating <input type="checkbox"/> Centrifugal <input type="checkbox"/> Other		
Medium sand & rock layers	180	195	18. Elevation:	19. Remarks: (Use a second sheet if needed)	20. Water well contractor's certification: This well was drilled under my jurisdiction and this report is true to the best of my knowledge and belief. JOE'S WELL SERVICE 179 Business name <u>Box 174</u> License No. Address <u>Cimarron, Ks.</u> Signed <u>Larry C. Chick</u> Date <u>6-16-76</u> Authorized representative
Topography: <input checked="" type="checkbox"/> Hill <input type="checkbox"/> Slope <input type="checkbox"/> Upland <input type="checkbox"/> Valley					