

1 LOCATION OF WATER WELL:	Fraction	Section Number	Township Number	Range Number
County: <u>GRAY</u>	<u>NCS 1/4 N 1/2 1/4 SE 1/4</u>	<u>18</u>	T <u>27</u> S <u>3</u>	R <u>28</u> E <u>W</u>

Distance and direction from nearest town or city street address of well if located within city?

2 WATER WELL OWNER: John B. UreuhRR#, St. Address, Box #: Box 156


Board of Agriculture, Division of Water Resources

City, State, ZIP Code: Montezuma, KS 66867Application Number: 13145

3 LOCATE WELL'S LOCATION WITH AN "X" IN SECTION BOX:

4 DEPTH OF COMPLETED WELL: 252 ft. ELEVATION:

AN "X" IN SECTION BOX:

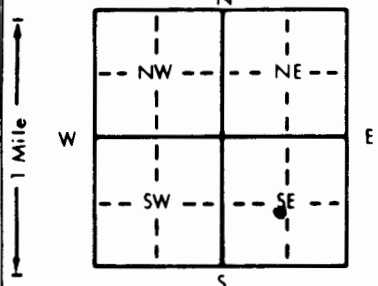

Depth(s) Groundwater Encountered 1. ft. 2. ft. 3. ft.

WELL'S STATIC WATER LEVEL ft. below land surface measured on mo/day/yr

Pump test data: Well water was ft. after hours pumping gpm

Est. Yield gpm: Well water was ft. after hours pumping gpm

Bore Hole Diameter in. to ft., and in. to ft.

WELL WATER TO BE USED AS: 5 Public water supply 8 Air conditioning 11 Injection well

1 Domestic 3 Feedlot 6 Oil field water supply 9 Dewatering 12 Other (Specify below)

2 Irrigation 4 Industrial 7 Lawn and garden only 10 Monitoring well

Was a chemical/bacteriological sample submitted to Department? Yes No; If yes, mo/day/yr sample was submitted

Water Well Disinfected? Yes No

5 TYPE OF BLANK CASING USED:

5 Wrought iron

8 Concrete tile

CASING JOINTS: Glued Clamped

1 Steel

3 RMP (SR)

6 Asbestos-Cement

9 Other (specify below)

Welded

2 PVC

4 ABS

7 Fiberglass

Threaded

Blank casing diameter 16 in. to 247 ft. Dia. in. to ft. Dia. in. to ft.Casing height above land surface +12 in., weight lbs./ft. Wall thickness or gauge No.

TYPE OF SCREEN OR PERFORATION MATERIAL:

1 Steel

3 Stainless steel

5 Fiberglass

7 PVC

10 Asbestos-cement

2 Brass

4 Galvanized steel

6 Concrete tile

8 RMP (SR)

11 Other (specify)

9 ABS

12 None used (open hole)

SCREEN OR PERFORATION OPENINGS ARE:

1 Continuous slot

3 Mill slot

5 Gauzed wrapped

8 Saw cut

11 None (open hole)

2 Louvered shutter

4 Key punched

6 Wire wrapped

9 Drilled holes

7 Torch cut

10 Other (specify)

SCREEN-PERFORATED INTERVALS: From 207 ft. to 247 ft. From ft. to ft.

From ft. to ft. From ft. to ft.

GRAVEL PACK INTERVALS: From 20 ft. to 252 ft. From ft. to ft.

From ft. to ft. From ft. to ft.

6 GROUT MATERIAL:

1 Neat cement

2 Cement grout

3 Bentonite

4 Other

Grout Intervals: From 0 ft. to 20 ft. From ft. to ft. From ft. to ft.

What is the nearest source of possible contamination:

1 Septic tank

4 Lateral lines

7 Pit privy

10 Livestock pens

14 Abandoned water well

2 Sewer lines

5 Cess pool

8 Sewage lagoon

11 Fuel storage

15 Oil well/Gas well

3 Watertight sewer lines

6 Seepage pit

9 Feedyard

12 Fertilizer storage

16 Other (specify below)

13 Insecticide storage

NONE

Direction from well?

How many feet?

FROM	TO	LITHOLOGIC LOG	FROM	TO	PLUGGING INTERVALS
0	20	Overburden: Clay	160	170	Sandy Clay, Bay Mixed Gravel
20	30	Sandy Clay	170	180	Clay, Sandy Clay 1/2 C. Lenses
30	40	Sandy Clay, Clay: Gravel Mix	180	190	Sandy Clay
40	50	Fine Sand	190	200	Sandy Clay
50	60	Fine Sand to Cemented Sand	200	210	Fine Sand, Gravel 1/2 C. Lenses
60	70	Sand Clay - Clotche	210	220	Fine Sand, Lenses 1/2 Clay, Sand
70	80	Sand: Gravel	220	240	Fine Sand to Med Gravel
80	90	Sand: Gravel	240	250	4' Med Gravel then Yellow Clay/Shale
90	100	Sand: Gravel	250	252	Shale
100	110	Sand: Gravel 1/2 Bay of Yell. Clay			
110	120	Sand: Gravel to Sandy Clay			
120	130	Sandy Clay Bay: Cemented Sand			
130	140	Cemented Sand: Clotche			
140	150	Cemented Sand: Clotche - Clay			
150	160	Clay 1/2 Supply Clay Bayard			

7 CONTRACTOR'S OR LANDOWNER'S CERTIFICATION: This water well was (1) constructed, (2) reconstructed, or (3) plugged under my jurisdiction and was completed on (mo/day/year) 4-24-92 and this record is true to the best of my knowledge and belief. KansasWater Well Contractor's License No. KS-300 This Water Well Record was completed on (mo/day/yr) 5-29-92under the business name of Tulton Drilling Co by (signature) [Signature]