


| | | | | | |
|---------------------------|--|--|----------------------|---------------------------|--------------------------|
| 1 LOCATION OF WATER WELL: | | Fraction SE $\frac{1}{4}$ SE $\frac{1}{4}$ NW $\frac{1}{4}$ | Section Number 28 | Township Number T 27 S | Range Number R 28 E/W |
|---------------------------|--|--|----------------------|---------------------------|--------------------------|

Distance and direction from nearest town or city street address of well if located within city?

From Cimarron, Ks. - 8 miles South, 2 miles West and $\frac{1}{2}$ mile West

| | | | | | |
|--------------------------|--|-------------------------|---|--|--|
| 2 WATER WELL OWNER: | | Vic Thomas | Board of Agriculture, Division of Water Resources | | |
| RR#, St. Address, Box #: | | Montezuma, Kansas 67867 | Application Number: | | |

| | | |
|--|--|---|
| 3 LOCATE WELL'S LOCATION WITH AN "X" IN SECTION BOX: | | 4 DEPTH OF COMPLETED WELL... 160 ft. ELEVATION: |
|--|--|---|

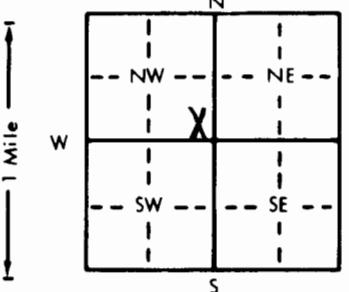

Depth(s) Groundwater Encountered 1. ft. 2. ft. 3. ft.

WELL'S STATIC WATER LEVEL ... 115 ft. below land surface measured on mo/day/yr ... 11-12-82

Pump test data: Well water was ft. after hours pumping gpm

Est. Yield ... 40 gpm: Well water was ft. after hours pumping gpm

Bore Hole Diameter ... 8 in. to ... 160 ft., and in. to ft.

WELL WATER TO BE USED AS: 5 Public water supply 8 Air conditioning 11 Injection well

1 Domestic 3 Feedlot 6 Oil field water supply 9 Dewatering 12 Other (Specify below)

2 Irrigation 4 Industrial 7 Lawn and garden only 10 Observation well ... stock well

Was a chemical/bacteriological sample submitted to Department? Yes No. XXXX; If yes, mo/day/yr sample was submitted

Water Well Disinfected? Yes XXX No

| | | | | |
|------------------------------|------------|-------------------|-------------------------|--|
| 5 TYPE OF BLANK CASING USED: | | 5 Wrought iron | 8 Concrete tile | CASING JOINTS: Glued ... XXX ... Clamped |
| 1 Steel | 3 RMP (SR) | 6 Asbestos-Cement | 9 Other (specify below) | Welded |
| 2 PVC | 4 ABS | 7 Fiberglass | | Threaded |

Blank casing diameter ... 5 in. to ... 160 ft., Dia in. to ft., Dia in. to ft.

Casing height above land surface ... 12 in., weight ... 200 psi lbs./ft. Wall thickness or gauge No. ... SDR 21

TYPE OF SCREEN OR PERFORATION MATERIAL:

| | | | | |
|---------|--------------------|------------------|------------|--------------------------|
| 1 Steel | 3 Stainless steel | 5 Fiberglass | 7 PVC | 10 Asbestos-cement |
| 2 Brass | 4 Galvanized steel | 6 Concrete tile | 8 RMP (SR) | 11 Other (specify) |
| | | 5 Gauzed wrapped | 9 ABS | 12 None used (open hole) |
| | | 6 Wire wrapped | | |
| | | 7 Torch cut | | |

SCREEN OR PERFORATION OPENINGS ARE:

| | | | |
|--------------------|---------------|----------------|--------------------------|
| 1 Continuous slot | 3 Mill slot | 6 Wire wrapped | 9 Drilled holes |
| 2 Louvered shutter | 4 Key punched | 7 Torch cut | 10 Other (specify) |

SCREEN-PERFORATED INTERVALS: From ... 135 ft. to ... 155 ft., From ft. to ft.

From ft. to ft., From ft. to ft.

GRAVEL PACK INTERVALS: From ... 12 ft. to ... 160 ft., From ft. to ft.

From ft. to ft., From ft. to ft.

6 GROUT MATERIAL: 1 Neat cement 2 Cement grout 3 Bentonite 4 Other

Grout Intervals: From ... 0 ft. to ... 12 ft., From ft. to ft., From ft. to ft.

What is the nearest source of possible contamination: none 10 Livestock pens 14 Abandoned water well

| | | | | |
|--------------------------|-----------------|-----------------|------------------------|--------------------------|
| 1 Septic tank | 4 Lateral lines | 7 Pit privy | 11 Fuel storage | 15 Oil well/Gas well |
| 2 Sewer lines | 5 Cess pool | 8 Sewage lagoon | 12 Fertilizer storage | 16 Other (specify below) |
| 3 Watertight sewer lines | 6 Seepage pit | 9 Feedyard | 13 Insecticide storage | |

Direction from well? How many feet?

| FROM | TO | LITHOLOGIC LOG | FROM | TO | LITHOLOGIC LOG |
|------|-----|--------------------------|------|----|----------------|
| 0 | 15 | Top soil & clay | | | |
| 15 | 30 | Clay | | | |
| 30 | 45 | Clay & fine sand | | | |
| 45 | 60 | Fine sand | | | |
| 60 | 90 | Fine sand & clay layers | | | |
| 90 | 105 | Fine sand to medium sand | | | |
| 105 | 155 | Medium to coarse sand | | | |
| 155 | 160 | Clay | | | |

7 CONTRACTOR'S OR LANDOWNER'S CERTIFICATION: This water well was (1) constructed, (2) reconstructed, or (3) plugged under my jurisdiction and was completed on (mo/day/year) ... Nov. 13, 1982 and this record is true to the best of my knowledge and belief. Kansas

Water Well Contractor's License No. ... 179 This Water Well Record was completed on (mo/day/yr) ... August 27, 1983

under the business name of Joe's Well Service, Inc. Cimarron, Ks. by (signature) Judith Cieck

INSTRUCTIONS: Use typewriter or ball point pen, PLEASE PRESS FIRMLY and PRINT clearly. Please fill in blanks, underline or circle the correct answers. Send top three copies to Kansas Department of Health and Environment, Division of Environment, Environmental Geology Section, Topeka, KS 66620. Send one to WATER WELL OWNER and retain one for your records.