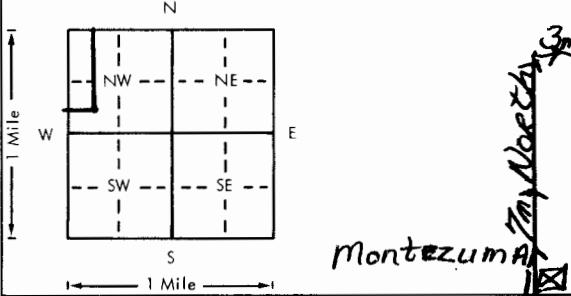


USE TYPEWRITER OR BALL  
POINT PEN-PRESS FIRMLY,  
PRINT CLEARLY.

CWW Inv. #15615

Maxwell #2

1. Location of well:	County	Fraction	Section number	Township number	Range number		
1. Location of well:	County Gray	Fraction 1/4 SW 1/4 NW 1/4	Section number 28	T 27S S R	Range number 28W E/W		
2. Distance and direction from nearest town or city:	From West edge of Montezuma, KS go 7m North - 3m East - 1½m South & East to location.					3. Owner of well: Rains & Williamson Oil Co.	
			R.R. or street: 435 Page Crt., 220 W. Douglas	City, state, zip code: Wichita, Kansas 67202			
4. Locate with "X" in section below:	Sketch map:					6. Bore hole dia. 9 in. Completion date 3-13-79 Well depth 240 ft.	
						7. Cable tool <input checked="" type="checkbox"/> Rotary <input type="checkbox"/> Driven <input type="checkbox"/> Dug <input type="checkbox"/> Hollow rod <input type="checkbox"/> Jetted <input type="checkbox"/> Bored <input type="checkbox"/> Reverse rotary	
5. Type and color of material	From	To	8. Use: <input type="checkbox"/> Domestic <input type="checkbox"/> Public supply <input checked="" type="checkbox"/> Industry <input type="checkbox"/> Irrigation <input type="checkbox"/> Air conditioning <input type="checkbox"/> Stock <input type="checkbox"/> Lawn <input checked="" type="checkbox"/> Oil field water <input type="checkbox"/> Other				
Surface	0	2	9. Casing: Material <input type="checkbox"/> Height: Above or below Threaded <input type="checkbox"/> Welded <input type="checkbox"/> Surface 28 in. RMP <input type="checkbox"/> PVC <input checked="" type="checkbox"/> Weight 2.78 lbs./ft. Dia. 5 in. to 100 ft. depth Wall Thickness: inches or Dia. 5 in. to 220 ft. depth gage No. 265				
Clay 80% & fine sand 20%	2	22	10. Screen: Manufacturer's name <input type="checkbox"/> Sawed perf.				
Clay 60% & medium to large sand 40%	22	44	Type PVC Dia. 5" Slot/gauze .030 Length 120' Set between 100 ft. and 220 ft. ft. and ft. Gravel pack? yes Size range of material 1/8-3/16				
Clay	44	78	11. Static water level: 100 ft. below land surface Date 3/13/79				
Medium to large sand 35% & Gravel 65%	78	170	12. Pumping level below land surfaces: ft. after hrs. pumping g.p.m. ft. after hrs. pumping g.p.m. Estimated maximum yield 60 g.p.m.				
Clay	170	175	13. Water sample submitted: Yes <input checked="" type="checkbox"/> No Date				
Medium to large sand 55% & Gravel 45%	175	197	14. Well head completion: <input type="checkbox"/> Pitless adapter 28 Inches above grade				
Clay	197	240	15. Well grouted? yes With: <input checked="" type="checkbox"/> Neat cement <input type="checkbox"/> Bentonite <input type="checkbox"/> Concrete Depth: From 0 ft. to 10 ft.				
(Use a second sheet if needed)				16. Nearest source of possible contamination: ft. 100 Direction NE Type oilwell Well disinfected upon completion? <input checked="" type="checkbox"/> Yes <input type="checkbox"/> No			
18. Elevation:	19. Remarks:					17. Pump: <input checked="" type="checkbox"/> Not installed Manufacturer's name Model number HP Volts Length of drop pipe ft. capacity g.p.m. Type: <input type="checkbox"/> Submersible <input type="checkbox"/> Turbine <input type="checkbox"/> Jet <input type="checkbox"/> Reciprocating <input type="checkbox"/> Centrifugal <input type="checkbox"/> Other	
Topography: <input type="checkbox"/> Hill <input type="checkbox"/> Slope <input checked="" type="checkbox"/> Upland <input type="checkbox"/> Valley						20. Water well contractor's certification: This well was drilled under my jurisdiction and this report is true to the best of my knowledge and belief. <u>Carlile Water Well Service 118</u> Business name License No. Address Box AA, Liberal, KS Signed <u>Edward E. Means</u> Date 3-21-79 Authorized representative	