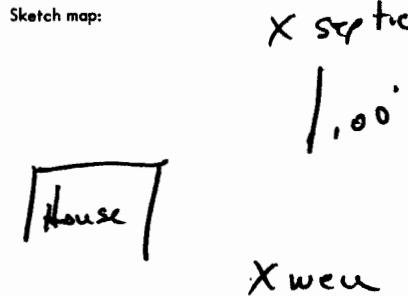


USE TYPEWRITER OR BALL
POINT PEN-PRESS FIRMLY,
PRINT CLEARLY.

WATER WELL RECORD
KSA 82a-1201-1215

Kansas Department of Health and
Environment-Division of Environment
(Water well Contractors)
Topeka, Kansas 66620

Location

1. Location of well:	County Gray	Fraction SW 1/4 NE 1/4 SE 1/4	Section number 34	Township number T 27 S R 28	Range number #10
2. Distance and direction from nearest town or city: Street address of well location if in city:	8 miles W Cimarron KS		3. Owner of well: R.R. or street: Donald Skinner RR 1	City, state, zip code: Cimarron, KS 67835	
4. Locate with "X" in section below:	Sketch map: 		6. Bore hole dia. 5 in. Completion date 8-26-77 Well depth 260 ft.		
			7. <input checked="" type="checkbox"/> Cable tool <input type="checkbox"/> Rotary <input type="checkbox"/> Driven <input type="checkbox"/> Dug <input type="checkbox"/> Hollow rod <input type="checkbox"/> Jetted <input type="checkbox"/> Bored <input type="checkbox"/> Reverse rotary		
			8. Use: <input checked="" type="checkbox"/> Domestic <input type="checkbox"/> Public supply <input type="checkbox"/> Industry <input type="checkbox"/> Irrigation <input type="checkbox"/> Air conditioning <input type="checkbox"/> Stock <input type="checkbox"/> Lawn <input type="checkbox"/> Oil field water <input type="checkbox"/> Other		
			9. Casing: Material Plastic Length: Above or below Threaded <input type="checkbox"/> Welded <input type="checkbox"/> Surface 18 in. RMP 100 PVC glue Weight 250 lbs./ft. Dia. 5 in. to 260 ft. depth Wall Thickness: inches or Dia. 5 in. to 260 ft. depth gage No. 250		
5. Type and color of material			From	To	10. Screen: Manufacturer's name Jens & Konsell
Topsoil			0	2'	Type Plastic Dia. 5"
Clay			2	25	Slot/gage 30' Length 30'
Sandy soil			25	100	Set between 230 ft. and 260 ft.
Clay			100	170	ft. and 260 ft.
Gravel			170	260	Gravel pack? yes Size range of material +
					11. Static water level: 200 ft. below land surface Date 8-25-77
					12. Pumping level below land surfaces: N/A
					ft. after 0 hrs. pumping 9 p.m.
					ft. after 0 hrs. pumping 9 p.m.
					Estimated maximum yield 0 g.p.m.
					13. Water sample submitted: no Date 8-25-77
					Yes <input checked="" type="checkbox"/> No <input type="checkbox"/>
					14. Well head completion: pitless adapter 18 inches above grade
					15. Well grouted? yes
					With: <input checked="" type="checkbox"/> Neat cement <input type="checkbox"/> Bentonite <input type="checkbox"/> Concrete
					Depth: From 3 ft. to 20 ft.
					16. Nearest source of possible contamination: 100 ft. west Type Septic
					Well disinfected upon completion? <input checked="" type="checkbox"/> Yes <input type="checkbox"/> No
					17. Pump: submersible Not installed
					Manufacturer's name Dempster
					Model number CH15058 HP 1/2 Volts 250
					Length of drop pipe 210 ft. capacity 80 g.p.m.
					Type: <input checked="" type="checkbox"/> Submersible <input type="checkbox"/> Turbine <input type="checkbox"/> Jet <input type="checkbox"/> Reciprocating <input type="checkbox"/> Centrifugal <input type="checkbox"/> Other
18. Elevation: Level Topography: <input checked="" type="checkbox"/> Hill <input checked="" type="checkbox"/> Slope <input type="checkbox"/> Upland <input type="checkbox"/> Valley					
19. Remarks: (Use a second sheet if needed)					
20. Water well contractor's certification: This well was drilled under my jurisdiction and this report is true to the best of my knowledge and belief. Gragg Well Drilling 111 Business name Gragg Well Drilling License No. 111 Address 1308 So Second Dodge City Signed Ray Dugg Date 8/27/77 Authorized representative					