

WATER WELL RECORD

Form WWC-5

Division of Water Resources; App. No.

1 LOCATION OF WATER WELL:

County: Gray

Fraction

SW 1/4 SW 1/4 SE 1/4

Section Number

30

Township Number

T 27 S

Range Number

R 28 E/WDistance and direction from nearest town or city street address of well if located within city? From Montezuma, Jct. Hwy. 56 & 13rd. 4 1/4 miles north, then 1/2 east.

2 WATER WELL OWNER:

Owner: Deverne KoehnRR#, St. Address, Box # : 13705 X Rd.City, State, ZIP Code : Montezuma, KS. 67867

Global Positioning Systems (decimal degrees, min. of 4 digits)

Latitude:

Longitude:

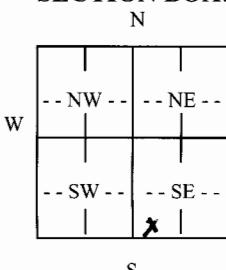
Elevation:

Datum:

Data Collection Method:

3 LOCATE WELL'S

LOCATION

WITH AN "X" IN
SECTION BOX:4 DEPTH OF COMPLETED WELL 225 ft.Depth(s) Groundwater Encountered (1) ft. (2) ft. (3) ft.
WELL'S STATIC WATER LEVEL 189 ft. below land surface measured on mo/day/yr. 8-30-05

Pump test data: Well water was ft. after hours pumping gpm

Est. Yield gpm: Well water was ft. after hours pumping gpm

WELL WATER TO BE USED AS: 5 Public water supply 8 Air conditioning 11 Injection well

1 Domestic 3 Feedlot 6 Oil field water supply 9 Dewatering 12 Other (Specify below)

2 Irrigation 4 Industrial 7 Domestic (lawn & garden) 10 Monitoring well

Was a chemical/bacteriological sample submitted to Department? Yes No If yes, mo/day/yr
Sample was submitted Water well disinfected? Yes No

5 TYPE OF CASING USED:

1 Steel 3 RMP (SR) 5 Wrought Iron 6 Asbestos-Cement
2 PVC 4 ABS 7 Fiberglass

8 Concrete tile

9 Other (specify below)

CASING JOINTS: Glued Clamped

Welded

Threaded

Blank casing diameter 5 in. to 185 ft., Diameter in. to ft., Diameter in. to ft.Casing height above land surface 13 in., Weight lbs./ft. Wall thickness or guage No. SDR 21

TYPE OF SCREEN OR PERFORATION MATERIAL:

1 Steel 3 Stainless Steel 5 Fiberglass 7 PVC 9 ABS 11 Other (Specify)
2 Brass 4 Galvanized Steel 6 Concrete tile 8 RM (SR) 10 Asbestos-Cement 12 None used (open hole)

SCREEN OR PERFORATION OPENINGS ARE:

1 Continuous slot 3 Mill slot 5 Guazed wrapped 7 Torch cut 9 Drilled holes 11 None (open hole)
2 Louvered shutter 4 Key punched 6 Wire wrapped 8 Saw Cut 10 Other (specify)SCREEN-PERFORATED INTERVALS: From 185 ft. to 225 ft., From ft. to ft.

From ft. to ft., From ft. to ft.

GRAVEL PACK INTERVALS: From 24 ft. to 225 ft., From ft. to ft.
From ft. to ft., From ft. to ft.

6 GROUT MATERIAL: 1 Neat cement 2 Cement grout 3 Bentonite 4 Other

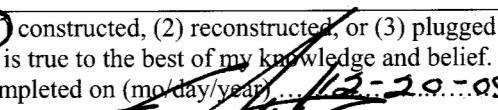
Grout Intervals: From 4 ft. to 34 ft., From ft. to ft., From ft. to ft.

What is the nearest source of possible contamination:

1 Septic tank 4 Lateral lines 7 Pit privy 10 Livestock pens 13 Insecticide Storage 16 Other (specify)
2 Sewer lines 5 Cess pool 8 Sewage lagoon 11 Fuel storage 14 Abandoned water well below)
3 Watertight sewer lines 6 Seepage pit 9 Feedyard 12 Fertilizer Storage 15 Oil well/gas wellDirection from well? NorthHow many feet? 20

FROM TO LITHOLOGIC LOG FROM TO PLUGGING INTERVALS

| | | | | | |
|------------|------------|---------------------------------------|--|--|--|
| <u>0</u> | <u>2</u> | <u>Topsoil</u> | | | |
| <u>2</u> | <u>60</u> | <u>Brown sandy clay</u> | | | |
| <u>60</u> | <u>85</u> | <u>Brown sandy clay & Caliche</u> | | | |
| <u>85</u> | <u>90</u> | <u>Course sand</u> | | | |
| <u>90</u> | <u>91</u> | <u>Sandrock</u> | | | |
| <u>91</u> | <u>100</u> | <u>Course sand</u> | | | |
| <u>100</u> | <u>110</u> | <u>Brown clay</u> | | | |
| <u>110</u> | <u>225</u> | <u>Course sand</u> | | | |

7 CONTRACTOR'S OR LANDOWNER'S CERTIFICATION: This water well was (1) constructed, (2) reconstructed, or (3) plugged under my jurisdiction and was completed on (mo/day/year) 8-30-05 and this record is true to the best of my knowledge and belief.Kansas Water Well Contractor's License No. 533 This Water Well Record was completed on (mo/day/year) 8-20-05under the business name of Santzen Water Well by (signature) INSTRUCTIONS: Use typewriter or ball point pen. PLEASE PRESS FIRMLY and PRINT clearly. Please fill in blanks, underline or circle the correct answers. Send top three copies to Kansas Department of Health and Environment, Bureau of Water, Geology Section, 1000 SW Jackson St., Suite 420, Topeka, Kansas 66121-1367. Telephone 785-296-5522. Send one to WATER WELL OWNER and retain one for your records. Fee of \$5.00 for each constructed well. Visit us at <http://www.kdhe.state.ks.us/geo/waterwells>.