


1	LOCATION OF WATER WELL:	Fraction SE NW NW ¼ ¼ ¼	Section Number 34	Township Number 27	Range Number 28 E/W
---	-------------------------	-------------------------------	----------------------	-----------------------	--

County: Gray
 Distance and direction from nearest town or city street address of well if located within city?
from Hayward, 1/2 mile west to 19th, 1 mile north to Ford Ensign rd., 3 miles west to 16 rd. north 3/4 mile then 1/4 mile northeast.

2 WATER WELL OWNER: Don Skinner
 RR #, St. Address, Box #: 1002 Summerlon Way
 City, State, ZIP Code : Dodge City, Ks. 67801
 Board of Agriculture, Division of Water Resources
 Application Number: _____

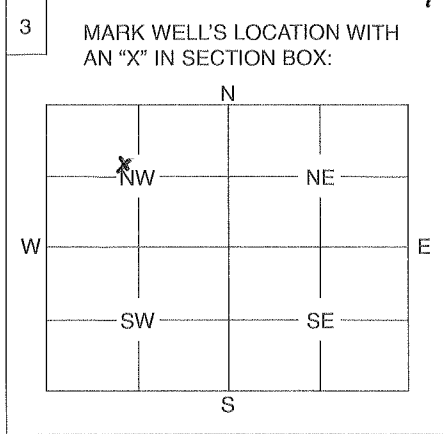

4 DEPTH OF WELL 232 ft.
 WELL'S STATIC WATER LEVEL 212 ft.
 WELL WAS USED AS:

1 Domestic	5 Public Water Supply	9 Dewatering
2 Irrigation	6 Oil Field Water Supply	10 Monitoring Well
3 Feedlot	7 Domestic (Lawn & Garden)	11 Injection Well
4 Industrial	8 Air Conditioning	12 Other

Was a chemical / bacteriological sample submitted to Department? Yes No
 If yes, mo/day/yr sample was submitted

Water Well Disinfected: Yes No

5 TYPE OF BLANK CASING USED:

<input checked="" type="radio"/> Steel	3 RMP (SR)	5 Wrought	7 Fiberglass	9 Other (Specify below)
2 PVC	4 ABS	6 Asbestos-Cement	8 Concrete Tile

Blank casing diameter in. Was casing pulled? Yes No If yes, how much

Casing height above or below land surface in.

6 GROUT PLUG MATERIAL: 1 Neat cement 2 Cement grout Bentonite 4 Other

Grout Plug Intervals: From 4 ft. to 8 ft., From ft. to ft., From to ft.

What is the nearest source of possible contamination:

1 Septic tank	6 Seepage pit	11 Fuel storage	16 Other (specify below)
2 Sewer lines	7 Pit privy	12 Fertilizer storage	<u>None Observed</u>
3 Watertight sewer lines	8 Sewage lagoon	13 Insecticide storage	
4 Lateral lines	9 Feedyard	14 Abandoned water well	
5 Cess pool	10 Livestock pens	15 Oil well/Gas well	

Direction from well? How many feet?

FROM	TO	PLUGGING MATERIALS
4	8	Bentonite Chips
8	212	Compacted slays
212	232	Chlorinated sand

7 CONTRACTOR'S OF LANDOWNER'S CERTIFICATION: This water well was plugged under my jurisdiction and was completed on (mo/day/year) 11/25/14 and this record is true to the best of my knowledge and belief. Kansas Water Well Contractor's License No. 533 This Water Well Record was completed on (mo/day/year) 12/20/14 under the business name of Jantzen Water Well by (signature) _____

INSTRUCTIONS: Use typewriter or ball point pen. Please press firmly and print clearly. Please fill in blanks, underline or circle the correct answers. Send top three copies to Kansas Department of Health and Environment, Bureau of Water, Geology Section, 1000 SW Jackson St., Ste. 420, Topeka, Kansas 66612-1367. Telephone: 785/296-5522. Send one to Water Well Owner and retain one for your records.