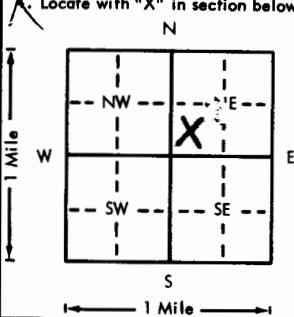


USE TYPEWRITER OR BALL  
POINT PEN-PRESS FIRMLY,  
PRINT CLEARLY.

WATER WELL RECORD  
KSA 82a-1201-1215

Kansas Department of Health and  
Environment-Division of Environment  
(Water well Contractors)  
Topeka, Kansas 66620

<input checked="" type="checkbox"/> Location of well:	County <b>GRAY</b>	Fraction <b>NE 1/4 SW 1/4 NE 1/4</b>	Section number <b>12</b>	Township number <b>T 27 S</b>	Range number <b>R 29 NW</b>
<input checked="" type="checkbox"/> Distance and direction from nearest town or city: <b>Montezuma 3 1/4 North 3/4 West - North into quarter</b> <input type="checkbox"/> Street address of well location if in city:		3. Owner of well: <b>Dee Wayne Koehn</b> R.R. or street: _____ City, state, zip code: <b>Ingalls, Kansas 67853</b>			
<input checked="" type="checkbox"/> Locate with "X" in section below: 					
Sketch map: _____					
6. Bore hole dia. <b>26</b> in. Completion date <b>9-30-75</b> Well depth <b>250</b> ft.					
7. <input type="checkbox"/> Cable tool <input type="checkbox"/> Rotary <input type="checkbox"/> Driven <input type="checkbox"/> Dug <input type="checkbox"/> Hollow rod <input type="checkbox"/> Jetted <input type="checkbox"/> Bored <input checked="" type="checkbox"/> Reverse rotary					
8. Use: <input type="checkbox"/> Domestic <input type="checkbox"/> Public supply <input type="checkbox"/> Industry <input checked="" type="checkbox"/> Irrigation <input type="checkbox"/> Air conditioning <input type="checkbox"/> Stock <input type="checkbox"/> Lawn <input type="checkbox"/> Oil field water <input type="checkbox"/> Other					
9. Casing: Material <b>Steel</b> Height: Above <b>12</b> in. Threaded <input type="checkbox"/> Welded <input checked="" type="checkbox"/> Surface <b>12</b> in. RMP <b>36.87</b> lbs./ft. Dia. <b>16</b> in. to <b>251</b> ft. depth Wall Thickness: inches or Dia. <b>16</b> in. to <b>251</b> ft. depth Gage No. <b>219</b>					
10. Screen: Manufacturer's name <b>Johnson Division</b> Type <b>Galvanized</b> Dia. <b>16"</b> Slot/gauze _____ Length <b>20'</b> Set between <b>175</b> ft. and <b>195</b> ft. Perf: <b>100-175</b> ft. and <b>225-250</b> ft. Gravel pack? <b>Yes</b> Size range of material <b>1"</b> down					
11. Static water level: <b>82</b> ft. below land surface Date <b>8-26-75</b>					
12. Pumping level below land surfaces: 99 ft. after <b>1 1/2</b> hrs. pumping <b>726</b> g.p.m. 111 ft. after <b>3</b> hrs. pumping <b>1321</b> g.p.m. Estimated maximum yield <b>1300</b> g.p.m.					
13. Water sample submitted: <b>mo./day/yr.</b> Yes <input checked="" type="checkbox"/> No <input type="checkbox"/> Date _____					
14. Well head completion: <input type="checkbox"/> Pitless adapter <b>12</b> inches above grade					
15. Well grouted? <b>Yes</b> With: <input checked="" type="checkbox"/> Neat cement <input type="checkbox"/> Bentonite <input type="checkbox"/> Concrete Depth: From <b>0</b> ft. to <b>10</b> ft.					
16. Nearest source of possible contamination: ft. _____ Direction _____ Type <b>N/A</b> Well disinfected upon completion? <b>Yes</b> <input checked="" type="checkbox"/> No _____					
17. Pump: <input type="checkbox"/> Not installed Manufacturer's name <b>Peerless - FMC</b> Model number <b>05316</b> HP <b>100</b> Volts _____ Length of drop pipe <b>160</b> ft. capacity <b>1300</b> g.p.m. Type: <input type="checkbox"/> Submersible <input checked="" type="checkbox"/> Turbine <input type="checkbox"/> Jet <input type="checkbox"/> Reciprocating <input type="checkbox"/> Centrifugal <input type="checkbox"/> Other					
(Use a second sheet if needed)					
18. Elevation:	19. Remarks:				
Topography: <input checked="" type="checkbox"/> Hill <input checked="" type="checkbox"/> Slope <input type="checkbox"/> Upland <input type="checkbox"/> Valley	20. Water well contractor's certification: This well was drilled under my jurisdiction and this report is true to the best of my knowledge and belief. <b>Minter-Wilson Drilling 208</b> Business name _____ License No. _____ Address _____ Signed _____ Date _____ Authorized representative _____				

**SHAWNEE STATEWATER WOOD DRILLING CO.**  
INCORPORATED

Irrigation  
and Domestic  
Water Systems  
Complete Installation  
and Repairing

Phone 214-8205 P.O. Box 493 • GARDEN CITY, KANSAS 67846

DeWayne Koehn  
Gray County  
7-28-75

Location: First road east of Ben Koehn's house,  $\frac{1}{4}$  mile south, 100 ft. west NE 12-27-29

Test #3

0	2	Top soil
2	17	Fine sand
17	32	Brown clay
32	47	Fine sand
47	65	Brown sandy clay
65	155	Fine to med. sand & gravel, streaks of clay, 5%
155	161	Brown clay & white rock
161	196	Fine to med. sand & gravel
196	230	Brown sandy clay
230	245	Fine to med. sand & gravel
245	293	Brown clay
293	296	Brown, yellow & gray clay & white rock
296	305	Shale (hard)

Static Water Level: 80

T.D. 245'