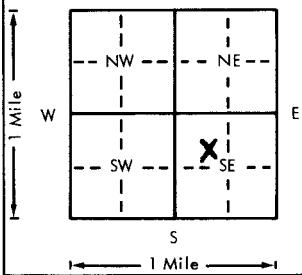


USE TYPEWRITER OR BALL
POINT PEN-PRESS FIRMLY,
PRINT CLEARLY.

WATER WELL RECORD
KSA 82a-1201-1215

Kansas Department of Health and
Environment-Division of Environment
(Water well Contractors)
Topeka, Kansas 66620

<input checked="" type="checkbox"/> Location of well:	County	Fraction	Section number	Township number	Range number	
	Gray	SE 1/4 NW 1/4 SE 1/4	13	T 27	S R 29 <i>SW</i>	
<input checked="" type="checkbox"/> Distance and direction from nearest town or city:	Montezuma 6 1/4 North		3. Owner of well:	Paul Yost		
<input checked="" type="checkbox"/> Street address of well location:	West 1/4 North		R.R. or street:	Montezuma, Ks. 67867		
4. Locate with "X" in section below:	Sketch map:		6. Bore hole dia.	26	in. Completion date <u>10-16-76</u>	
			Well depth	290	ft.	
5. Type and color of material	From	To	7. <input type="checkbox"/> Cable tool <input type="checkbox"/> Rotary <input type="checkbox"/> Driven <input type="checkbox"/> Dug <input type="checkbox"/> Hollow rod <input type="checkbox"/> Jetted <input type="checkbox"/> Bored <input checked="" type="checkbox"/> Reverse rotary	8. Use: <input type="checkbox"/> Domestic <input type="checkbox"/> Public supply <input type="checkbox"/> Industry <input checked="" type="checkbox"/> Irrigation <input type="checkbox"/> Air conditioning <input type="checkbox"/> Stock <input type="checkbox"/> Lawn <input type="checkbox"/> Oil field water <input type="checkbox"/> Other		
			9. Casing: Material <u>steel</u> Height: Above or below Threaded <input type="checkbox"/> Welded <input checked="" type="checkbox"/> Surface <u>12</u> in. RMP <input type="checkbox"/> PVC <input type="checkbox"/> Weight <u>36.87</u> lbs./ft. Dia. <u>16</u> in. to <u>29 1/4</u> ft. depth Wall thickness: inches or Dia. <input type="checkbox"/> in. to <input type="checkbox"/> ft. depth gage No. <u>250</u>	10. Screen: Manufacturer's name <u>Johnson</u> Type <u>galv.</u> Dia. <u>16"</u> Slot size <input type="checkbox"/> Length <u>20</u> ft. Set between <u>260</u> ft. and <u>280</u> ft. Perf: <u>120-260</u> ft. and <u>280-290</u> ft. Gravel pack? <u>yes</u> Size range of material <u>3" down</u>		
			11. Static water level: <u>85</u> ft. below land surface Date <u>9-16-76</u>	12. Pumping level below land surfaces: <u>100</u> ft. after <u>3</u> hrs. pumping <u>1450</u> g.p.m. <input type="checkbox"/> ft. after <input type="checkbox"/> hrs. pumping <input type="checkbox"/> g.p.m. Estimated maximum yield <u>1450</u> g.p.m.		
			13. Water sample submitted: <input type="checkbox"/> Yes <input checked="" type="checkbox"/> No Date <input type="checkbox"/>	14. Well head completion: <input type="checkbox"/> Pitless adapter <u>12</u> Inches above grade		
			15. Well grouted? <u>yes</u> With: <input type="checkbox"/> Neat cement <input type="checkbox"/> Bentonite <input checked="" type="checkbox"/> Concrete Depth: From <u>0</u> ft. to <u>10</u> ft.	16. Nearest source of possible contamination: <u>N/A</u> ft. <input type="checkbox"/> Direction <input type="checkbox"/> Type <input type="checkbox"/> Well disinfected upon completion? <input type="checkbox"/> Yes <input checked="" type="checkbox"/> No		
			17. Pump: <input type="checkbox"/> Not installed Manufacturer's name <u>Goulds - US Pump</u> Model number <u>12JHC</u> HP <u>100</u> Volts <input type="checkbox"/> Length of drop pipe <u>120</u> ft. capacity <u>1200</u> g.p.m. Type: <input type="checkbox"/> Submersible <input checked="" type="checkbox"/> Turbine <input type="checkbox"/> Jet <input type="checkbox"/> Reciprocating <input type="checkbox"/> Centrifugal <input type="checkbox"/> Other	12 29 13 14 14 14		
(Use a second sheet if needed)						
18. Elevation:	19. Remarks:					20. Water well contractor's certification: This well was drilled under my jurisdiction and this report is true to the best of my knowledge and belief. <u>Minter-Wilson Drilling Co.</u> 208 Business name <input type="checkbox"/> License No. Address <u>Box A Garden City, Ks.</u> Signed <u>John Minter</u> Date <u>5-24-77</u> Authorized representative
Topography: <input type="checkbox"/> Hill <input checked="" type="checkbox"/> Slope <input type="checkbox"/> Upland <input type="checkbox"/> Valley						

WILSON DRILLING CO. INCORPORATED

Irrigation
and Domestic
Water Systems
Complete Installation
and Repairing

Phone 276-8269

P.O. Box 493 ~ GARDEN CITY, KANSAS 67846

PAUL YOST (ROY YOST)

GRAY COUNTY

3-70-76

Location: NE 1/4 S-27-29 from well #16 1/2 mile north 3/4 miles west
1 mile south west 3/4 south 1/4 mile west at
pivot well #15

Static Water Level - 30'

Test #2

0	10	Fine sand
20	52	Brown sandy clay
52	80	Fine to med. sand and gravel loose
80	100	Med. to coarse gravel
100	140	Fine to med. sand and gravel loose
140	170	Fine to med. sand and gravel scks. of clay 10% loose
170	180	Fine to med. sand and gravel loose
180	180	Brown sandy clay
189	250	Brown sandy clay scks. of fine sand and white rock 50% silt
250	290	Fine to med. sand and gravel loose
290	304	Brown clay
304	309	Brown and yellow clay
309	310	Shale

T.D. 290'