

USE TYPEWRITER OR BALL
POINT PEN-PRESS FIRMLY,
PRINT CLEARLY.

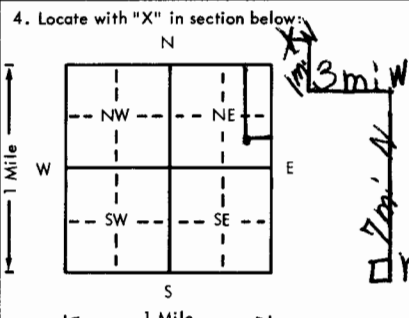
CWWInv. 15895

WATER WELL RECORD
KSA 82a-1201-1215

Kansas Department of Health and
Environment-Division of Environment
(Water well Contractors)
Topeka, Kansas 66620

Permit # T79-91

Pendleton Land & Exp. #2

1. Location of well:	County Gray	Fraction 1/4 SE 1/4 NE 1/4	Section number 16	Township number T 27N	Range number S R 29 E/W
2. Distance and direction from nearest town or city: From Montezuma go 7mi North 3mi West 1mi North and back West to Location			3. Owner of well: Rains & Williamson R.R. or street: 435 Page Court City, state, zip code: Wichita, Kansas 67202		
4. Locate with "X" in section below: 			6. Bore hole dia. 9 in. Completion date 6-4-79 Well depth 220		
5. Type and color of material			7. <input checked="" type="checkbox"/> Cable tool <input checked="" type="checkbox"/> Rotary <input type="checkbox"/> Driven <input type="checkbox"/> Dug <input type="checkbox"/> Hollow rod <input type="checkbox"/> Jetted <input type="checkbox"/> Bored <input type="checkbox"/> Reverse rotary		
Surface			8. Use: <input type="checkbox"/> Domestic <input type="checkbox"/> Public supply <input type="checkbox"/> Industry <input type="checkbox"/> Irrigation <input type="checkbox"/> Air conditioning <input type="checkbox"/> Stock <input type="checkbox"/> Lawn <input checked="" type="checkbox"/> Oil field water <input type="checkbox"/> Other		
Clay			9. Casing: Material <input type="checkbox"/> Height: Above or below Threaded <input type="checkbox"/> Welded <input type="checkbox"/> Surface 28 in. RMP <input type="checkbox"/> PVC <input checked="" type="checkbox"/> Weight 2.78 lbs./ft. Dia 9 in. to 140 ft. depth Wall Thickness: inches or Dia. <input type="checkbox"/> in. to <input type="checkbox"/> ft. depth gage No 265		
Clay 30% & fine sand 70%			10. Screen: Manufacturer's name Saved perf. Type PVC Dia. 5" Slot/gauze <input type="checkbox"/> Length 80 Set between 140 ft. and 220 ft. <input type="checkbox"/> ft. and <input type="checkbox"/> ft.		
Clay 15% & fine sand 85%			11. Static water level: <input type="checkbox"/> mo./day/yr. 76 ft. below land surface Date 6-4-79		
Clay			12. Pumping level below land surfaces: <input type="checkbox"/> ft. after <input type="checkbox"/> hrs. pumping <input type="checkbox"/> g.p.m. <input type="checkbox"/> ft. after <input type="checkbox"/> hrs. pumping <input type="checkbox"/> g.p.m. Estimated maximum yield 60 g.p.m.		
Medium to large sand			13. Water sample submitted: <input type="checkbox"/> mo./day/yr. Yes <input checked="" type="checkbox"/> No Date <input type="checkbox"/>		
(Use a second sheet if needed)			14. Well head completion: <input type="checkbox"/> Pitless adapter 28 inches above grade		
			15. Well grouted? Yes With: <input checked="" type="checkbox"/> Neat cement <input type="checkbox"/> Bentonite <input type="checkbox"/> Concrete Depth: From 0 ft. to 10 ft.		
			16. Nearest source of possible contamination: ft. 100 Direction NE Type oilwell Well disinfected upon completion? <input checked="" type="checkbox"/> Yes <input type="checkbox"/> No		
			17. Pump: <input checked="" type="checkbox"/> Not installed Manufacturer's name <input type="checkbox"/> Model number <input type="checkbox"/> HP <input type="checkbox"/> Volts <input type="checkbox"/> Length of drop pipe <input type="checkbox"/> ft. capacity <input type="checkbox"/> g.p.m. Type: <input type="checkbox"/> Submersible <input type="checkbox"/> Turbine <input type="checkbox"/> Jet <input type="checkbox"/> Reciprocating <input type="checkbox"/> Centrifugal <input type="checkbox"/> Other		
18. Elevation:	19. Remarks:		20. Water well contractor's certification: This well was drilled under my jurisdiction and this report is true to the best of my knowledge and belief. 118 Carlile Water Well Service Business name Box AA, Liberal, KS. License No. 67901 Address 6-8- Signed Edward E. Mease Date 6-8-79 Authorized representative		

Forward the white, blue and pink copies to the Department of Health and Environment

Form WWC-5