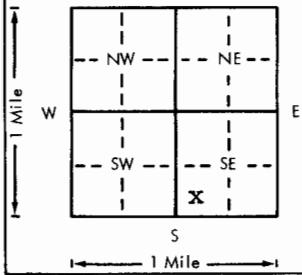


USE TYPEWRITER OR BALL
POINT PEN-PRESS FIRMLY,
PRINT CLEARLY.

WATER WELL RECORD
KSA 82a-1201-1215

Kansas Department of Health and
Environment-Division of Environment
(Water well Contractors)
Topeka, Kansas 66620

Location of well:	County	Fraction	Section number	Township number	Range number
X	Gray	SW 1/4 SW 1/4 SE 1/4	17	T 27 S	R 29 W E/W
X. Distance and direction from nearest town or city: 7 north & 3 1/2 west of Montezuma, Ks.		3. Owner of well: David Schmidt			
Street address of well location if in city:		R.R. or street: City, state, zip code: Montezuma, Kansas 67867			
4. Locate with "X" in section below:		Sketch map:			
		6. Bore hole dia. 9 7/8 in. Completion date _____ Well depth 246 ft. 7-17-78			
		7. <input checked="" type="checkbox"/> Cable tool <input checked="" type="checkbox"/> Rotary <input type="checkbox"/> Driven <input type="checkbox"/> Dug <input type="checkbox"/> Hollow rod <input type="checkbox"/> Jetted <input type="checkbox"/> Bored <input type="checkbox"/> Reverse rotary			
		8. Use: <input checked="" type="checkbox"/> Domestic <input type="checkbox"/> Public supply <input type="checkbox"/> Industry <input type="checkbox"/> Irrigation <input type="checkbox"/> Air conditioning <input type="checkbox"/> Stock <input type="checkbox"/> Lawn <input type="checkbox"/> Oil field water <input type="checkbox"/> Other			
		9. Casing: Material PVC Height: Above or below Threaded <input type="checkbox"/> Welded <input checked="" type="checkbox"/> Surface 12 in. RMP <input type="checkbox"/> PVC <input checked="" type="checkbox"/> Weight 2.8 lbs./ft. Dia. 5 in. to 246 ft. depth Wall Thickness: inches or Dia. ____ in. to ____ ft. depth gage No. 265			
5. Type and color of material		From	To	10. Screen: Manufacturer's name Pumpco	
Top soil		0	6	Type PVC	Dia. 5"
Clay		6	13	Slot/____	1/8" Length 60'
Sandy clay		13	55	Set between	186 ft. and 246 ft.
Med. to lar. sand, gravel & rocks		55	162	ft. and _____ ft.	
Med. to lar. sand & gravel - some clay		162	173	Gravel pack? Yes Size range of material 1 1/4-5 1/2	
Clay		173	178	11. Static water level: mo./day/yr. 80 ft. below land surface Date 7/14/78	
Med. to lar. sand & clay		178	200	12. Pumping level below land surfaces: ft. after ____ hrs. pumping ____ g.p.m. ft. after ____ hrs. pumping ____ g.p.m. Estimated maximum yield 100-150 g.p.m.	
Med. to lar. sand		200	251	13. Water sample submitted: mo./day/yr. Yes <input checked="" type="checkbox"/> No Date	
Bit stopped - very hard		251		14. Well head completion: <input checked="" type="checkbox"/> Pitless adapter Unit _____ Inches above grade	
				15. Well grouted? Yes With: <input checked="" type="checkbox"/> Neat cement <input type="checkbox"/> Bentonite <input type="checkbox"/> Concrete Depth: From 4 ft. to 14 ft.	
				16. Nearest source of possible contamination: ft. 100 Direction north Type corrells Well disinfected upon completion? XX Yes No	
				17. Pump: Not installed Manufacturer's name Aermotor Model number SD12 HP 1 Volts 220 Length of drop pipe 126 ft. capacity 10 g.p.m. Type: <input checked="" type="checkbox"/> Submersible <input type="checkbox"/> Turbine <input type="checkbox"/> Jet <input type="checkbox"/> Reciprocating <input type="checkbox"/> Centrifugal <input type="checkbox"/> Other	
(Use a second sheet if needed)				18. Elevation: 19. Remarks:	
Topography: <input type="checkbox"/> Hill <input type="checkbox"/> Slope <input checked="" type="checkbox"/> Upland <input type="checkbox"/> Valley		20. Water well contractor's certification: This well was drilled under my jurisdiction and this report is true to the best of my knowledge and belief. Friesen Windmill 252 Business name Meade, Kansas 67864 License No. Address Signed <input type="checkbox"/> Authorized representative Date 7-14-78			