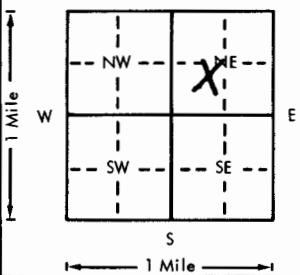


USE TYPEWRITER OR BALL
POINT PEN-PRESS FIRMLY,
PRINT CLEARLY.

WATER WELL RECORD
KSA 82a-1201-1215

Kansas Department of Health and
Environment-Division of Environment
(Water well Contractors)
Topeka, Kansas 66620

1. Location of well:	County Gray	Fraction NE 1/4 SW 1/4 NE 1/4	Section number 17	Township number T 27	Range number S R 29	10W
2. Distance and direction from nearest town or city:	8 south of Ingalls		3. Owner of well: Richard Jantz	Montezuma, KS 67867		
1 1/2 west 1/2 south Street address of well location if in city:			R.R. or street: City, state, zip code:			
4. Locate with "X" in section below:	Sketch map: 			6. Bore hole dia. 26 in. Completion date 12-15-76 Well depth 220 ft.		
5. Type and color of material	From	To	7. <input type="checkbox"/> Cable tool <input type="checkbox"/> Rotary <input type="checkbox"/> Driven <input type="checkbox"/> Dug <input type="checkbox"/> Hollow rod <input checked="" type="checkbox"/> Jetted <input type="checkbox"/> Bored <input checked="" type="checkbox"/> Reverse rotary			
			8. Use: <input type="checkbox"/> Domestic <input type="checkbox"/> Public supply <input type="checkbox"/> Industry <input checked="" type="checkbox"/> Irrigation <input type="checkbox"/> Air conditioning <input type="checkbox"/> Stock <input type="checkbox"/> Lawn <input type="checkbox"/> Oil field water <input type="checkbox"/> Other			
			9. Casing: Material <input type="checkbox"/> steel Height: Above or below Threaded <input type="checkbox"/> Welded <input checked="" type="checkbox"/> Surface 12 in. RMP <input type="checkbox"/> PVC <input type="checkbox"/> Weight 36.87 lbs./ft. Dia. 16 in. to 22 ft. depth Wall Thickness: inches or Dia. <input type="checkbox"/> in. to <input type="checkbox"/> ft. depth gage No. <input type="checkbox"/>			
			10. Screen: Manufacturer's name <input type="checkbox"/> Johnson Screen Type <input type="checkbox"/> Galv. Dia. 16" Slot/gauze <input type="checkbox"/> Length 20' Set between 190 ft. and 210 ft. Perf: 120-190 and 210-220 ft. Gravel pack? <input checked="" type="checkbox"/> Size range of material 1" down			
			11. Static water level: <input type="checkbox"/> 74 ft. below land surface Date 12-9-76 mo./day/yr.			
			12. Pumping level below land surfaces: 96 ft. after 2 hrs. pumping 1000 g.p.m. 109 ft. after 4 hrs. pumping 1550 g.p.m. Estimated maximum yield 1550 g.p.m.			
			13. Water sample submitted: <input type="checkbox"/> Yes <input checked="" type="checkbox"/> No Date <input type="checkbox"/>			
			14. Well head completion: <input type="checkbox"/> Pitless adapter 12 inches above grade			
			15. Well grouted? <input checked="" type="checkbox"/> Yes With: <input type="checkbox"/> Neat cement <input type="checkbox"/> Bentonite <input checked="" type="checkbox"/> Concrete Depth: From 0 ft. to 10 ft.			
			16. Nearest source of possible contamination: <input type="checkbox"/> N/A ft. <input type="checkbox"/> Direction <input type="checkbox"/> Type Field Well disinfected upon completion? <input type="checkbox"/> Yes <input checked="" type="checkbox"/> No			
			17. Pump: <input type="checkbox"/> Not installed Manufacturer's name <input type="checkbox"/> Goulds Pumps Model number <input type="checkbox"/> 12JHC HP 175 Volts <input type="checkbox"/> Length of drop pipe 180 ft. capacity 1000 g.p.m. Type: <input type="checkbox"/> Submersible <input checked="" type="checkbox"/> Turbine <input type="checkbox"/> Jet <input type="checkbox"/> Reciprocating <input type="checkbox"/> Centrifugal <input type="checkbox"/> Other			
(Use a second sheet if needed)			20. Water well contractor's certification: This well was drilled under my jurisdiction and this report is true to the best of my knowledge and belief. <input type="checkbox"/> Minter Wilson Drilling <input type="checkbox"/> 208 Business name <input type="checkbox"/> License No. Address <input type="checkbox"/> P.O. Box A Garden City, KS Signed <input type="checkbox"/> M. Wilson Date 2-24-77 Authorized representative <input type="checkbox"/>			
18. Elevation:	19. Remarks:					
Topography: <input type="checkbox"/> Hill <input checked="" type="checkbox"/> Slope <input type="checkbox"/> Upland <input type="checkbox"/> Valley						

MINTER-WILSON DRILLING CO.

INCORPORATED

Irrigation
and Domestic
Water Systems
Complete Installation
and Repairing

Phone 276-8269 • P.O. Box 493 • GARDEN CITY, KANSAS 67846

RICHARD JANTZ

GRAY COUNTY

9-13-76

Location: NE $\frac{1}{4}$ 17-27-29 200 Ft. east of Test #1
Static Water Level- 90'

Test #2

0	1	Top soil
1	6	Fine sand
6	22	Brown clay
22	46	Brown sandy clay
46	96	Med. coarse gravel
96	113	Med. coarse gravel Loose
113	127	Fine to med. sand and gravel
127	136	Brown gray clay mixed
136	141	Brown sandy clay gravel stks.
141	154	Brown sandy clay
153	166	Fine to med. sand
166	167	Brown sandy clay
169	190	Fine sand clay stks.
194	224	Med. coarse gravel tanish mixed yellow white rock
220	227	Yellow clay Hard Pale Green
227	231	Yellow clay mixed with rock Hard Pale Green
234	246	Yellow