


1 LOCATION OF WATER WELL:		Fraction County: GRAY SW 1/4 SW 1/4	Section Number 19	Township Number T 27 S	Range Number R 29 E
---------------------------	--	--	----------------------	---------------------------	------------------------

Distance and direction from nearest town or city street address of well if located within city?

77 E. SOUTH INGALLS, 3 M. W., 3M. S, 1 M. W. NORTH SIDE

2 WATER WELL OWNER:		RICHARD MILLERSHASKI	Board of Agriculture, Division of Water Resources		
RR#, St. Address, Box # :		INGALLS, KS.	Application Number:		
City, State, ZIP Code :					

3 LOCATE WELL'S LOCATION WITH AN "X" IN SECTION BOX:		4 DEPTH OF COMPLETED WELL 280 ft. ELEVATION: .....			
--	--	--	--	--	--

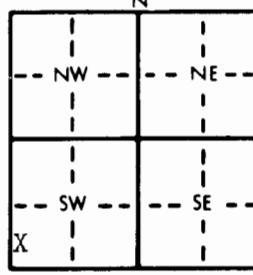

Depth(s) Groundwater Encountered 1 ft. 2 ft. 3 ft.

WELL'S STATIC WATER LEVEL 115 ft. below land surface measured on mo/day/yr 3/11/87

Pump test data: Well water was ft. after hours pumping gpm

Est. Yield gpm: Well water was ft. after hours pumping gpm

Bore Hole Diameter 9 7/8 in. to 290 ft. and in. to ft.

WELL WATER TO BE USED AS: 5 Public water supply 8 Air conditioning 11 Injection well

1 Domestic 3 Feedlot 6 Oil field water supply 9 Dewatering 12 Other (Specify below)

2 Irrigation 4 Industrial 7 Lawn and garden only 10 Observation well

Was a chemical/bacteriological sample submitted to Department? Yes No. X; If yes, mo/day/yr sample was submitted

Water Well Disinfected? Yes X No

5 TYPE OF BLANK CASING USED:		5 Wrought iron	8 Concrete tile	CASING JOINTS: Glued .. X .. Clamped .....
1 Steel	3 RMP (SR)	6 Asbestos-Cement	9 Other (specify below)	Welded .....
2 PVC	4 ABS	7 Fiberglass		Threaded .....

Blank casing diameter 5 in. to 250 ft., Dia in. to ft., Dia in. to ft.

Casing height above land surface 20 in., weight 200 lbs./ft. Wall thickness or gauge No. ....

TYPE OF SCREEN OR PERFORATION MATERIAL:		10 PVC	10 Asbestos-cement
1 Steel	3 Stainless steel	5 Fiberglass	11 Other (specify) .....
2 Brass	4 Galvanized steel	6 Concrete tile	12 None used (open hole) .....

SCREEN OR PERFORATION OPENINGS ARE: 5 Gauzed wrapped 8 Saw cut 11 None (open hole)

1 Continuous slot 3 Mill slot 6 Wire wrapped 9 Drilled holes

2 Louvered shutter 4 Key punched 7 Torch cut 10 Other (specify) .....

SCREEN-PERFORATED INTERVALS: From 250 ft. to 280 ft., From ft. to ft. From ft. to ft.

GRAVEL PACK INTERVALS: From 100 ft. to 280 ft., From ft. to ft. From ft. to ft.

From ft. to ft. From ft. to ft.

6 GROUT MATERIAL: 1 Neat cement 2 Cement grout 3 Bentonite 4 Other .....

Grout Intervals: From 1 ft. to 30 ft., From ft. to ft., From ft. to ft., From ft. to ft.

What is the nearest source of possible contamination: 10 Livestock pens 14 Abandoned water well

1 Septic tank 4 Lateral lines 7 Pit privy 11 Fuel storage 15 Oil well/Gas well


2 Sewer lines 5 Cess pool 8 Sewage lagoon 12 Fertilizer storage 16 Other (specify below)

3 Watertight sewer lines 6 Seepage pit 9 Feedyard 13 Insecticide storage .....

Direction from well? west How many feet? 100

FROM	TO	LITHOLOGIC LOG	FROM	TO	LITHOLOGIC LOG
0	5	FINE SAND			
5	21	GRAY CLAY			
21	30	REAL FINE SAND			
30	40	GRAY CLAY			
40	58	VBROWN SANDY CLAY			
58	152	COURSE GRAVEL			
152	210	BROWN SANDY CLAY			
210	226	FINE SAND			
226	242	BROWN SANDY CLAY			
242	280	FINE TO MED SAND AND GRAVEL			

7 CONTRACTOR'S OR LANDOWNER'S CERTIFICATION: This water well was (1) constructed, (2) reconstructed, or (3) plugged under my jurisdiction and was completed on (mo/day/year) 3/11/87 and this record is true to the best of my knowledge and belief. Kansas

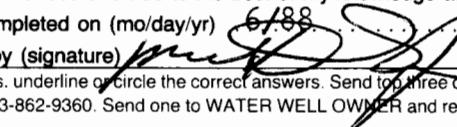Water Well Contractor's License No. 172 This Water Well Record was completed on (mo/day/yr) 6/18/88  
under the business name of JONAGAN DRILLING CO. by (signature) 

INSTRUCTIONS: Use typewriter or ball point pen. PLEASE PRESS FIRMLY and PRINT clearly. Please fill in blanks, underline or circle the correct answers. Send two three copies to Kansas Department of Health and Environment, Bureau of Water Protection, Topeka, Kansas 66620-7320, Telephone: 913-862-9360. Send one to WATER WELL OWNER and retain one for your records.