


1 LOCATION OF WATER WELL:		Fraction NE $\frac{1}{4}$ SW $\frac{1}{4}$ NW $\frac{1}{4}$	Section Number 27	Township Number T 27 S	Range Number R 29 EW
---------------------------	--	--	----------------------	---------------------------	-------------------------

Distance and direction from nearest town or city street address of well if located within city?

10 miles south of Ingalls highway and $\frac{1}{4}$ mile west

2 WATER WELL OWNER:		BEN SCHMIDT			Board of Agriculture, Division of Water Resources
RR#, St. Address, Box #		MONTEZUMA, KS.			Application Number:
City, State, ZIP Code					

3 LOCATE WELL'S LOCATION WITH AN "X" IN SECTION BOX:		4 DEPTH OF COMPLETED WELL: 190 ft. ELEVATION:		
--	--	---	--	--

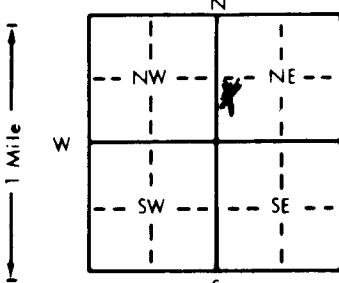

Depth(s) Groundwater Encountered 1. ft. 2. ft. 3. ft.

WELL'S STATIC WATER LEVEL 108 ft. below land surface measured on mo/day/yr 7/24/89

Pump test data: Well water was ft. after hours pumping gpm

Est. Yield gpm: Well water was ft. after hours pumping gpm

Bore Hole Diamet~~9~~ 7/8 in. to 240 ft., and in. to ft.

WELL WATER TO BE USED AS: 5 Public water supply 8 Air conditioning 11 Injection well

✓ Domestic 3 Feedlot 6 Oil field water supply 9 Dewatering 12 Other (Specify below)
2 Irrigation 4 Industrial 7 Lawn and garden only 10 Monitoring well

Was a chemical/bacteriological sample submitted to Department? Yes No. If yes, mo/day/yr sample was submitted

Water Well Disinfected? Yes No

5 TYPE OF BLANK CASING USED:		5 Wrought iron	8 Concrete tile	CASING JOINTS: Glued ✓ Clamped
------------------------------	--	----------------	-----------------	--------------------------------------

1 Steel 3 RMP (SR) 6 Asbestos-Cement 9 Other (specify below) Welded

✓ PVC 4 ABS 7 Fiberglass Threaded

Blank casing diameter 5 in. to 160 ft. Dia. in. to ft. Dia. in. to ft.

Casing height above land surface 20 in., weight 250 lbs./ft. Wall thickness or gauge No.

TYPE OF SCREEN OR PERFORATION MATERIAL:

1 Steel 3 Stainless steel 5 Fiberglass 8 RMP (SR) 10 Asbestos-cement

2 Brass 4 Galvanized steel 6 Concrete tile 9 ABS 11 Other (specify)

SCREEN OR PERFORATION OPENINGS ARE:

1 Continuous slot 2 Mill slot 5 Gauzed wrapped 8 Saw cut 11 None (open hole)

2 Louvered shutter 4 Key punched 6 Wire wrapped 9 Drilled holes

7 Torch cut 10 Other (specify)

SCREEN-PERFORATED INTERVALS: From 160 ft. to 190 ft., From ft. to ft. ft. to ft.

From ft. to ft. From ft. to ft. ft. to ft.

GRAVEL PACK INTERVALS: From 150 ft. to 190 ft., From ft. to ft. ft. to ft.

From ft. to ft. From ft. to ft. ft. to ft.

6 GROUT MATERIAL:		1 Neat cement	2 Cement grout	✓ Bentonite	4 Other
-------------------	--	---------------	----------------	-------------	---------------

Grout Intervals: From 100 ft. to 150 ft., From ft. to ft., From ft. to ft., From ft. to ft.

What is the nearest source of possible contamination:

✓ Septic tank 4 Lateral lines 7 Pit privy 10 Livestock pens 14 Abandoned water well

2 Sewer lines 5 Cess pool 8 Sewage lagoon 11 Fuel storage 15 Oil well/Gas well

3 Watertight sewer lines 6 Seepage pit 9 Feedyard 12 Fertilizer storage 16 Other (specify below)

Direction from well? W

How many feet? 100 ft.

FROM	TO	LITHOLOGIC LOG	FROM	TO	PLUGGING INTERVALS
------	----	----------------	------	----	--------------------

0	8	TOPO SOIL			
8	23	GRAY CLAY			
23	58	BROWN SANDY CLAY			
58	136	COURSE GRAVEL			
136	140	HARD ROCK			
140	173	COURSE GRAVEL			
173	230	BROWN SANDY CLAY			
230	240	FINE ST. FINE SAND AND GRAVEL			

7 CONTRACTOR'S OR LANDOWNER'S CERTIFICATION: This water well was ~~not~~ constructed, (2) reconstructed, or (3) plugged under my jurisdiction and was completed on (mo/day/year) 7-89 and this record is true to the best of my knowledge and belief. Kansas

Water Well Contractor's License No. 172 This Water Well Record was completed on (mo/day/yr) 7-90 under the business name of *TON ACAN DRILLING* by (signature) *Mark S. Jr.*