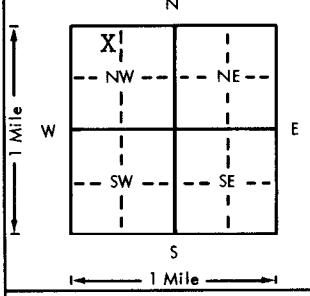


USE TYPEWRITER OR BALL
POINT PEN-PRESS FIRMLY,
PRINT CLEARLY.

WATER WELL RECORD
KSA 82a-1201-1215

Kansas Department of Health and
Environment-Division of Environment
(Water well Contractors)
Topeka, Kansas 66620

1. Location of well:	County Gray	Fraction NW 1/4 NW 1/4 NE 1/4	Section number 29	Township number T 27 S	Range number R 29 NW		
2. Distance and direction from nearest town or city:		3. Owner of well: R.R. or street: City, state, zip code: Daniel Unruh Montezuma, Kansas 67867					
4. Locate with "X" in section below: Sketch map: 							
5. Type and color of material		From	To	6. Bore hole dia. 9 7/8 in. Completion date 7-07-76 Well depth 152 ft. 7. <input type="checkbox"/> Cable tool <input checked="" type="checkbox"/> Rotary <input type="checkbox"/> Driven <input type="checkbox"/> Dug <input type="checkbox"/> Hollow rod <input type="checkbox"/> Jetted <input type="checkbox"/> Bored <input type="checkbox"/> Reverse rotary 8. Use: <input type="checkbox"/> Domestic <input type="checkbox"/> Public supply <input type="checkbox"/> Industry <input type="checkbox"/> Irrigation <input type="checkbox"/> Air conditioning <input checked="" type="checkbox"/> Stock <input type="checkbox"/> Lawn <input type="checkbox"/> Oil field water <input type="checkbox"/> Other 9. Casing: Material PVC Height: Above or below Threaded <input type="checkbox"/> Welded <input checked="" type="checkbox"/> Surface 12 in. RMP <input type="checkbox"/> PVC <input type="checkbox"/> Weight lbs./ft. Dia. 5 in. to 152 ft. depth Wall Thickness: inches or Dia. <input type="checkbox"/> in. to <input type="checkbox"/> ft. depth gage No. .265 10. Screen: Manufacturer's name Jess & Lowell Type PVC Dia. Slot/gauze 1/8" Length 40' Set between 112 ft. and 152 ft. ft. and <input type="checkbox"/> ft. Gravel pack? yes Size range of material 3/16" 11. Static water level: mo./day/yr. 72 ft. below land surface Date 6/28/76 12. Pumping level below land surfaces: ft. after <input type="checkbox"/> hrs. pumping <input type="checkbox"/> g.p.m. ft. after <input type="checkbox"/> hrs. pumping <input type="checkbox"/> g.p.m. Estimated maximum yield <input type="checkbox"/> g.p.m. 13. Water sample submitted: mo./day/yr. Yes <input checked="" type="checkbox"/> No Date 14. Well head completion: Pitless adapter 12 Inches above grade 15. Well grouted? yes With: <input type="checkbox"/> Neat cement <input type="checkbox"/> Bentonite <input checked="" type="checkbox"/> Concrete Depth: From 0 ft. to 10 ft. 16. Nearest source of possible contamination: 1/2 mile Directions: Southwest Type: old well Well disinfected upon completion? <input checked="" type="checkbox"/> Yes <input type="checkbox"/> No 17. Pump: Not installed Manufacturer's name Aermotor Mill Model number <input type="checkbox"/> HP <input type="checkbox"/> Volts Length of drop pipe 125 ft. capacity 3 g.p.m. Type: <input type="checkbox"/> Submersible <input type="checkbox"/> Turbine <input type="checkbox"/> Jet <input type="checkbox"/> Reciprocating <input type="checkbox"/> Centrifugal <input checked="" type="checkbox"/> Other 18. Elevation: Topography: <input type="checkbox"/> Hill <input type="checkbox"/> Slope <input checked="" type="checkbox"/> Upland <input type="checkbox"/> Valley 19. Remarks: (Use a second sheet if needed)		20. Water well contractor's certification: This well was drilled under my jurisdiction and this report is true to the best of my knowledge and belief. Friesen Windmill 252 Business name Meade, Kansas 67864 License No. Address <input type="checkbox"/> Signed <input checked="" type="checkbox"/> Date 9-1-X Signed <input checked="" type="checkbox"/> Authorized representative	