

WATER WELL RECORD

Form WWC-5

KSA 82a-1212


1 LOCATION OF WATER WELL:	Fraction SW 1/4 SW 1/4	Section Number 30	Township Number T 27 S	Range Number R 29 E(W)
---------------------------	---------------------------	----------------------	---------------------------	---------------------------

Distance and direction from nearest town or city street address of well if located within city?

12 M. SOUTH INGALLS 5 M. WEST

2 WATER WELL OWNER:	ROBERT SMITH RR#, St. Address, Box # : City, State, ZIP Code :	Board of Agriculture, Division of Water Resources Application Number:
---------------------	--	--

3 LOCATE WELL'S LOCATION WITH AN "X" IN SECTION BOX:	4 DEPTH OF COMPLETED WELL ft. ELEVATION:
--	--

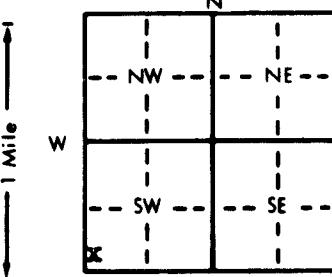

Depth(s) Groundwater Encountered 1. ft. 2. ft. 3. ft.

WELL'S STATIC WATER LEVEL ft. below land surface measured on mo/day/yr 3/19/87

Pump test data: Well water was ft. after hours pumping gpm

Est. Yield gpm: Well water was ft. after hours pumping gpm

Bore Hole Diameter 9 7/8 in. to 350 ft., and in. to ft.

WELL WATER TO BE USED AS: 5 Public water supply 8 Air conditioning 11 Injection well

10 Domestic 3 Feedlot 6 Oil field water supply 9 Dewatering 12 Other (Specify below)

2 Irrigation 4 Industrial 7 Lawn and garden only 10 Observation well

Was a chemical/bacteriological sample submitted to Department? Yes No If yes, mo/day/yr sample was submitted

Water Well Disinfected? Yes No

5 TYPE OF BLANK CASING USED:	5 Wrought iron	8 Concrete tile	CASING JOINTS: Glued <input checked="" type="checkbox"/> Clamped
------------------------------	----------------	-----------------	--

1 Steel 3 RMP (SR) 6 Asbestos-Cement 9 Other (specify below) Welded

2 PVC 4 ABS 7 Fiberglass Threaded

Blank casing diameter 5 in. to 330 ft., Dia in. to ft., Dia in. to ft.

Casing height above land surface 20 in., weight 200 lbs./ft. Wall thickness or gauge No.

TYPE OF SCREEN OR PERFORATION MATERIAL:	5 PVC	10 Asbestos-cement
---	-------	--------------------

1 Steel 3 Stainless steel 5 Fiberglass 8 RMP (SR) 11 Other (specify)

2 Brass 4 Galvanized steel 6 Concrete tile 9 ABS 12 None used (open hole)

SCREEN OR PERFORATION OPENINGS ARE:	330	5 Gauzed wrapped	8 Saw cut	11 None (open hole)
-------------------------------------	-----	------------------	-----------	---------------------

1 Continuous slot 2 Mill slot 6 Wire wrapped 9 Drilled holes

2 Louvered shutter 4 Key punched 7 Torch cut 10 Other (specify)

SCREEN-PERFORATED INTERVALS:	From 330 ft. to 350 ft., From ft. to ft.
------------------------------	--

From ft. to ft., From ft. to ft.

GRAVEL PACK INTERVALS:	From 100 ft. to 350 ft., From ft. to ft.
------------------------	--

From ft. to ft., From ft. to ft.

6 GROUT MATERIAL:	1 Neat cement	2 Cement grout	3 Bentonite	4 Other
-------------------	---------------	----------------	-------------	-------------------

Grout Intervals: From 4 ft. to 30 ft., From ft. to ft., From ft. to ft.

What is the nearest source of possible contamination:

1 Septic tank 4 Lateral lines 7 Pit privy 10 Livestock pens 14 Abandoned water well

2 Sewer lines 5 Cess pool 8 Sewage lagoon 11 Fuel storage 15 Oil well/Gas well

3 Watertight sewer lines 6 Seepage pit 9 Feedyard 12 Fertilizer storage 16 Other (specify below)

Direction from well? SE How many feet? 100

FROM	TO	LITHOLOGIC LOG	FROM	TO	LITHOLOGIC LOG
------	----	----------------	------	----	----------------

0	7	FINE SAND			
7	96	BROWN SANDY CLAY			
96	110	FINE TO MED SAND AND GRAVEL			
110	113	HARD ROCK			
110	122	FINE TO MED SAND AND GRAVEL			
122	146	BROWN SANDY CLAY			
146	158	FINE TO MED SAND			
158	173	BROWN SANDY CLAY			
173	190	FINE TO MED SAND AND GRAVEL			
190	210	BROWN CLAY			
210	220	FINE TO MED SAND			
220	300	BROWN CLAY			
300	315	FINE TO MED SAND			
315	335	BROWN CLAY			
335	350	FINE TO MED SAND AND GRAVEL			

7 CONTRACTOR'S OR LANDOWNER'S CERTIFICATION: This water well was constructed, (2) reconstructed, or (3) plugged under my jurisdiction and was completed on (mo/day/year) 3/19/87 and this record is true to the best of my knowledge and belief. Kansas

Water Well Contractor's License No. 172 This Water Well Record was completed on (mo/day/yr) 4/1/88

under the business name of JONAGAN DRILLING CO. by (signature) 

INSTRUCTIONS: Use typewriter or ball point pen. PLEASE PRESS FIRMLY and PRINT clearly. Please fill in blanks, underline or circle the correct answers. Send top three copies to Kansas Department of Health and Environment, Bureau of Water Protection, Topeka, Kansas 66620-7320, Telephone: 913-862-9360. Send one to WATER WELL OWNER and retain one for your records.

OFFICE USE ONLY

EW SEC

1/4

1/4