

USE TYPEWRITER OR BALL
POINT PEN-PRESS FIRMLY,
PRINT CLEARLY.

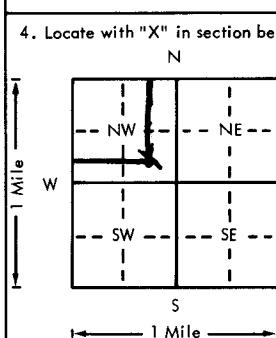
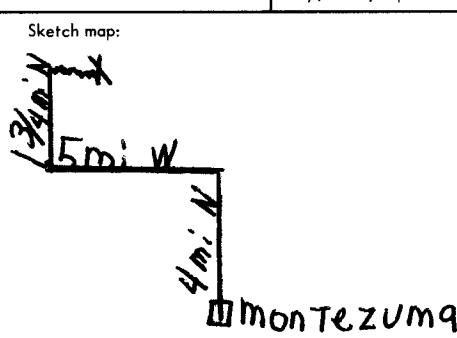
WATER WELL RECORD
KSA 82a-1201-1215

Kansas Department of Health and
Environment-Division of Environment
(Water well Contractors)
Topeka, Kansas 66620

Permit no 79-240

CWW 16438

Ginest #1

1. Location of well:	County Gray	Fraction 1/4 C-SE NW/4	Section number 30	Township number T 27 S 29 R E/W	Range number 29		
2. Distance and direction from nearest town or city: From Montezuma go 4 mi N. 5 mi W. 1 3/4 mi north	3. Owner of well: Rains & Williamson R.R. or street: 435 Page Court 220 West Douglas City, state, zip code: Wichita, Kansas 67202						
4. Locate with "X" in section below: 	Sketch map: 						
5. Type and color of material	From	To	6. Bore hole dia. 9 in. Completion date 11-6-79 Well depth 240 ft.				
Surface	0	2	7. <input type="checkbox"/> Cable tool <input checked="" type="checkbox"/> Rotary <input type="checkbox"/> Driven <input type="checkbox"/> Dug <input type="checkbox"/> Hollow rod <input type="checkbox"/> Jetted <input type="checkbox"/> Bored <input type="checkbox"/> Reverse rotary				
Clay	2	38	8. Use: <input type="checkbox"/> Domestic <input type="checkbox"/> Public supply <input type="checkbox"/> Industry <input type="checkbox"/> Irrigation <input type="checkbox"/> Air conditioning <input type="checkbox"/> Stock <input type="checkbox"/> Lawn <input checked="" type="checkbox"/> Oil field water <input type="checkbox"/> Other				
Medium to large sand	38	126	9. Casing: Material PVC Height: Above or below Threaded <input type="checkbox"/> Welded <input type="checkbox"/> Surface 28 in. RMP 2.78 lbs./ft.				
55% fine sand & 45% white rock	126	184	Dia. 5 in. to 140 depth Wall Thickness: inches or Dia. 5 in. to ft. depth gauge No. 256				
Medium to large sand	184	229	10. Screen: Manufacturer's name Sawed PVC Dia. 5" Slot/gauze .030 Length 100'				
55% fine sand & 45% white rock	229	240	Set between 140 ft. and 240 ft. ft. and ft. Gravel pack? Yes Size range of material 1/8-3/16				
			11. Static water level: 100 ft. below land surface Date 11-6-79				
			12. Pumping level below land surfaces: ft. after hrs. pumping g.p.m. ft. after hrs. pumping g.p.m. Estimated maximum yield 60 g.p.m.				
			13. Water sample submitted: Yes Date 11-6-79				
			14. Well head completion: <input checked="" type="checkbox"/> Pitless adapter 28 Inches above grade				
			15. Well grouted? Yes With: <input checked="" type="checkbox"/> Neat cement <input type="checkbox"/> Bentonite <input type="checkbox"/> Concrete Depth: From 0 ft. to 10 ft.				
			16. Nearest source of possible contamination: ft. 100 Direction N.E. Type oil well Well disinfected upon completion? <input checked="" type="checkbox"/> Yes <input type="checkbox"/> No				
			17. Pump: <input checked="" type="checkbox"/> Not installed Manufacturer's name Carlile Water Well Service Model number Box AA Liberal, Kansas HP 118 Volts 110 Length of drop pipe ft. capacity g.p.m. Type: <input type="checkbox"/> Submersible Turbine <input type="checkbox"/> Jet Reciprocating <input type="checkbox"/> Centrifugal Other				
(Use a second sheet if needed)			18. Elevation: 19. Remarks: Topography: <input type="checkbox"/> Hill <input type="checkbox"/> Slope <input checked="" type="checkbox"/> Upland <input type="checkbox"/> Valley				
20. Water well contractor's certification: This well was drilled under my jurisdiction and this report is true to the best of my knowledge and belief. 118 Carlile Water Well Service Business name Box AA Liberal, Kansas License No. 11-2-1259 Address Edward S. Meane Date 11-12-94 Signed Edward S. Meane Authorized representative							