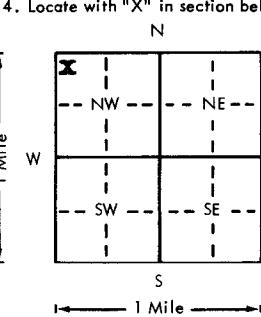


Ediger-Siemens

USE TYPEWRITER OR BALL
POINT PEN-PRESS FIRMLY,
PRINT CLEARLY...

WATER WELL RECORD
KSA 82a-1201-1215

Kansas Department of Health and
Environment-Division of Environment
(Water well Contractors)
Topeka, Kansas 66620

1. Location of well:	County	Fraction	Section number	Township number	Range number
	Gray	NW 1/4 NW 1/4 NW 1/4	35	T 27 S	R 29 E
2. Distance and direction from nearest town or city: 1 mi west-12 mi south of Ingalls, Ks Street address of well location if in city:	3. Owner of well: Ediger-Siemens R.R. or street: 521 Pamala City, state, zip code: Wichita, Kansas				
4. Locate with "X" in section below:	Sketch map: 				
5. Type and color of material	From	To	6. Bore hole dia. 28 in. Completion date 4-11-77 Well depth 220 ft.		
Surface	0	3	7. <input type="checkbox"/> Cable tool <input type="checkbox"/> Rotary <input type="checkbox"/> Driven <input type="checkbox"/> Dug <input type="checkbox"/> Hollow rod <input type="checkbox"/> Jetted <input type="checkbox"/> Bored <input checked="" type="checkbox"/> Reverse rotary		
Brown clay	3	10	8. Use: <input type="checkbox"/> Domestic <input type="checkbox"/> Public supply <input type="checkbox"/> Industry <input checked="" type="checkbox"/> Irrigation <input type="checkbox"/> Air conditioning <input type="checkbox"/> Stock <input type="checkbox"/> Lawn <input type="checkbox"/> Oil field water <input type="checkbox"/> Other		
Fine sand and brown clay streaks	10	73	9. Casing: Material Metal Height: Above or below Threaded <input type="checkbox"/> Welded <input checked="" type="checkbox"/> Surface 10 in. RMP <input type="checkbox"/> PVC <input type="checkbox"/> Weight 31.66 lbs./ft. Dia. 16 in. to 220 ft. depth Wall Thickness: inches or Dia. <input type="checkbox"/> in. to <input type="checkbox"/> ft. depth gage No. 188		
Med. to coarse sand and gravel	73	95	10. Screen: Manufacturer's name W.A. Brown & Cook		
Good med. sand and gravel with 10% clay streaks	95	105	Type 17% & 35% Dia. 16 Slot/gauze 1/8 Length 130		
Good med. sand and gravel	105	113	Set between 87 ft. and 217 ft. ft. and 217 ft. Gravel pack? <input checked="" type="checkbox"/> Size range of material 3/8 CMA		
Fine to med. sand with 40% clay mixed	113	142	11. Static water level: 90 ft. below land surface Date 4-28-77		
Good med. sand and gravel	142	148	12. Pumping level below land surfaces: 200 ft. after 3 hrs. pumping 800 g.p.m. 200 ft. after 3 hrs. pumping 800 g.p.m.		
Coleche clay	148	154	Estimated maximum yield 800 g.p.m.		
Coleche and brown sandy clay	154	170	13. Water sample submitted: Yes Date 4-28-77		
Fine sand with 10% clay	170	180	14. Well head completion: <input type="checkbox"/> Pitless adapter <input checked="" type="checkbox"/> Inches above grade		
Good med. sand	180	195	15. Well grouted? <input checked="" type="checkbox"/> With: <input type="checkbox"/> Neat cement <input type="checkbox"/> Bentonite <input checked="" type="checkbox"/> Concrete Depth: From 0 ft. to 10 ft.		
Fine sand with 10% clay mixed	195	210	16. Nearest source of possible contamination: ft. 130 Direction north Type centric Well disinfected upon completion? <input checked="" type="checkbox"/> Yes <input type="checkbox"/> No		
Yellow and brown clay with rock layers	210	235	17. Pump: <input type="checkbox"/> Not installed Manufacturer's name Goulds Model number 10 JHMC HP 100 Volts 650 Length of drop pipe 200 ft. capacity 650 g.p.m.		
Blue shale	235	240	Type: <input type="checkbox"/> Submersible <input checked="" type="checkbox"/> Turbine <input type="checkbox"/> Jet <input type="checkbox"/> Reciprocating <input type="checkbox"/> Centrifugal <input type="checkbox"/> Other		
(Use a second sheet if needed)					
18. Elevation:	19. Remarks:				
Topography: <input type="checkbox"/> Hill <input type="checkbox"/> Slope <input checked="" type="checkbox"/> Upland <input type="checkbox"/> Valley	20. Water well contractor's certification: This well was drilled under my jurisdiction and this report is true to the best of my knowledge and belief. Ace-Hi International 190 Business name Dodge City, Kansas License No. Address Dodge City, Kansas Signed Bailie C. Otto Date 4-11-77 Authorized representative				

Forward the white, blue and pink copies to the Department of Health and Environment

Form WWC-5