


1	LOCATION OF WATER WELL:	Fraction 1/4 1/4 1/4	Section Number 26	Township Number 27S	Range Number 29W EW
County: Gray					

Distance and direction from nearest town or city street address of well if located within city? **N/A**

2	WATER WELL OWNER: Frank and Gloria Penner	Board of Agriculture, Division of Water Resources
RR #, St. Address, Box #: 23903 12 Rd		Application Number:
City, State, ZIP Code: Montezuma KS 67867		

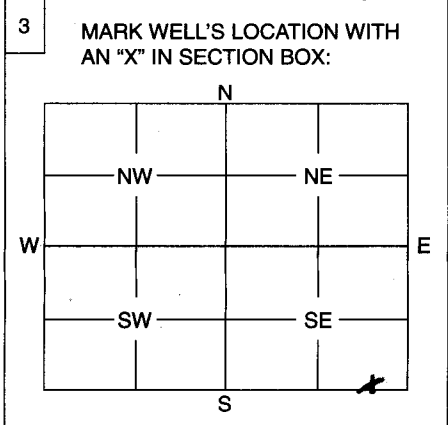

4	DEPTH OF WELL 157 ft.	WELL'S STATIC WATER LEVEL 155 ft.												
WELL WAS USED AS:														
<table style="width:100%; border:none;"> <tr> <td style="width:33%;"><input checked="" type="checkbox"/> Domestic</td> <td style="width:33%;">5 Public Water Supply</td> <td style="width:33%;">9 Dewatering</td> </tr> <tr> <td><input type="checkbox"/> 2 Irrigation</td> <td><input type="checkbox"/> 6 Oil Field Water Supply</td> <td><input type="checkbox"/> 10 Monitoring Well</td> </tr> <tr> <td><input checked="" type="checkbox"/> 3 Feeding</td> <td><input checked="" type="checkbox"/> 7 Domestic (Lawn & Garden)</td> <td><input type="checkbox"/> 11 Injection Well</td> </tr> <tr> <td><input type="checkbox"/> 4 Industrial</td> <td><input type="checkbox"/> 8 Air Conditioning</td> <td><input type="checkbox"/> 12 Other</td> </tr>
Was a chemical / bacteriological sample submitted to Department? Yes No <input checked="" type="checkbox"/>														
If yes, mo/day/yr sample was submitted														
Water Well Disinfected: Yes <input checked="" type="checkbox"/> No														

5	TYPE OF BLANK CASING USED:										
<table style="width:100%; border:none;"> <tr> <td style="width:25%;"><input checked="" type="checkbox"/> 1 Steel</td> <td style="width:25%;">3 RMP (SR)</td> <td style="width:25%;">5 Wrought</td> <td style="width:25%;">7 Fiberglass</td> </tr> <tr> <td><input checked="" type="checkbox"/> 2 PVC</td> <td><input type="checkbox"/> 4 ABS</td> <td><input type="checkbox"/> 6 Asbestos-Cement</td> <td><input type="checkbox"/> 8 Concrete Tile</td> </tr>
Blank casing diameter 5 in.			Was casing pulled? Yes No <input checked="" type="checkbox"/> If yes, how much								
Casing height above or below land surface 6 in.											

6	GROUT PLUG MATERIAL:	1 Neat cement	2 Cement grout	<input checked="" type="checkbox"/> 3 Bentonite	4 Other																		
Grout Plug Intervals: From 157 ft. to 3 ft., From 3 ft. to 0 ft., From to ft.																							
What is the nearest source of possible contamination:																							
<table style="width:100%; border:none;"> <tr> <td style="width:33%;">1 Septic tank</td> <td style="width:33%;">6 Seepage pit</td> <td style="width:33%;">11 Fuel storage</td> </tr> <tr> <td>2 Sewer lines</td> <td>7 Pit privy</td> <td>12 Fertilizer storage</td> </tr> <tr> <td>3 Watertight sewer lines</td> <td>8 Sewage lagoon</td> <td>13 Insecticide storage</td> </tr> <tr> <td><input checked="" type="checkbox"/> 4 Lateral lines</td> <td>9 Feedyard</td> <td>14 Abandoned water well</td> </tr> <tr> <td>5 Cess pool</td> <td>10 Livestock pens</td> <td>15 Oil well/Gas well</td> </tr> <tr> <td colspan="3">16 Other (specify below)</td> </tr>
Direction from well? NW			How many feet? 150 ft																				

FROM	TO	PLUGGING MATERIALS
150'	36'	Bentonite
36'	0'	Surface none

7	CONTRACTOR'S OF LANDOWNER'S CERTIFICATION: This water well was plugged under my jurisdiction and was completed on (mo/day/year) 11-01-04 and this record is true to the best of my knowledge and belief. Kansas Water Well Contractor's License No. This Water Well Record was completed on (mo/day/year)	
by (signature) Gloria Penner		under the business name of

INSTRUCTIONS: Use typewriter or ball point pen. Please press firmly and print clearly. Please fill in blanks, underline or circle the correct answers. Send top three copies to Kansas Department of Health and Environment, Bureau of Water, Geology Section, 1000 SW Jackson St., Ste. 420, Topeka, Kansas 66612-1367. Telephone: 785/296-5522. Send one to Water Well Owner and retain one for your records.