


1	LOCATION OF WATER WELL:	Fraction	Section Number	Township Number	Range Number
County:	Gran	NW $\frac{1}{4}$ NW $\frac{1}{4}$ NW $\frac{1}{4}$	33	T 27 S	R 29 E/W

Distance and direction from nearest town or city street address of well if located within city?  
From Montezuma, 3 miles north on 12 Rd. 4 miles west, then 1 mile north

2 WATER WELL OWNER: Roger Yost  
RR#, St. Address, Box # : 21505 8th.  
City, State, ZIP Code : Montezuma, Ks. 67867

Board of Agriculture, Division of Water Resources  
Application Number:

3	LOCATE WELL'S LOCATION WITH	4	DEPTH OF COMPLETED WELL ..... 240
---	-----------------------------	---	-----------------------------------

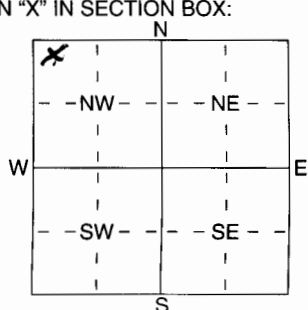

Depth(s) Groundwater Encountered 1 ..... ft. 2 ..... ft. 3 ..... ft.  
WELL'S STATIC WATER LEVEL 123 ..... ft. below land surface measured on mo/day/yr 2-10-05  
Pump test data: Well water was ..... ft. after ..... hours pumping ..... gpm  
Est. Yield ..... gpm: Well water was ..... ft. after ..... hours pumping ..... gpm  
WELL WATER TO BE USED AS:  
1 Domestic 3 Feedlot 5 Public water supply 8 Air conditioning 11 Injection well  
2 Irrigation 4 Industrial 6 Oil field water supply 9 Dewatering 12 Other (Specify below)  
7 Domestic (lawn & garden) 10 Monitoring well .....

Was a chemical/bacteriological sample submitted to Department? Yes ..... No ☒ .....; If yes, mo/day/yr sample was submitted  
Water Well Disinfected? Yes ☒ No

5	TYPE OF BLANK CASING USED:		5 Wrought iron	8 Concrete tile	CASING JOINTS: Glued <input checked="" type="checkbox"/> ..... Clamped ..... Welded <input type="checkbox"/> ..... Threaded <input type="checkbox"/> .....
	1 Steel	3 RMP (SR)	6 Asbestos-Cement	9 Other (specify below)	
	② PVC	4 ABS	7 Fiberglass		

Blank casing diameter 5 in. to 180 ft., Dia 180 in. to 180 ft., Dia 180 in. to 180 ft.  
Casing height above land surface 12 in., weight 12 lbs./ft. Wall thickness or gauge No. 50R21

TYPE OF SCREEN OR PERFORATION MATERIAL:

1 Steel	3 Stainless Steel	5 Fiberglass	7 PVC	10 Asbestos-Cement
2 Brass	4 Galvanized Steel	6 Concrete tile	8 RMP (SR)	11 Other (Specify) .....
			9 ABS	12 None used (open hole)

SCREEN OR PERFORATION OPENINGS ARE:

1 Continuous slot	3 Mill slot	5 Guazed wrapped	8 Saw cut	11 None (open hole)
2 Louvered shutter	4 Key punched	6 Wire wrapped	9 Drilled holes	
		7 Torch cut	10 Other (specify) .....	ft.

SCREEN-PERFORATED INTERVALS: From 180 ft. to 340 ft., From \_\_\_\_\_ ft. to \_\_\_\_\_ ft.  
From \_\_\_\_\_ ft. to \_\_\_\_\_ ft., From \_\_\_\_\_ ft. to \_\_\_\_\_ ft.

GRAVEL PACK INTERVALS: From 24 ft. to 240 ft., From \_\_\_\_\_ ft. to \_\_\_\_\_ ft.  
From \_\_\_\_\_ ft. to \_\_\_\_\_ ft., From \_\_\_\_\_ ft. to \_\_\_\_\_ ft.

6 GROUT MATERIAL: 1 Neat cement 2 Cement grout 3 Bentonite 4 Other \_\_\_\_\_  
Grout Intervals: From 4 ft. to 24 ft., From \_\_\_\_\_ ft. to \_\_\_\_\_ ft., From \_\_\_\_\_ ft. to \_\_\_\_\_ ft.

What is the nearest source of possible contamination:

1 Septic tank	4 Lateral lines	7 Pit privy	10 Livestock pens	<input checked="" type="checkbox"/> Abandoned water well
2 Sewer lines	5 Cess pool	8 Sewage lagoon	11 Fuel storage	15 Oil well/Gas well
3 Watertight sewer lines	6 Seepage pit	9 Feedyard	12 Fertilizer storage	16 Other (specify below)
			13 Insecticide storage	.....

Direction from well? North How many feet? 12

[illegible]

7 CONTRACTOR'S OR LANDOWNER'S CERTIFICATION: This water well was (1) constructed, (2) reconstructed, or (3) plugged under my jurisdiction and was completed on (mo/day/year) 2-10-05 and this record is true to the best of my knowledge and belief. Kansas Water Well Contractor's Licence No 533 This Water Well Record was completed on (mo/day/yr) 9-19-05 under the business name of Jantzen Water Well Repair by (signature) [Signature]