


1 LOCATION OF WATER WELL: Fraction Carter NW Section Number 28 Township Number 27 Range Number 27 E/W

Distance and direction from nearest town or city street address of well if located within city?

Approx 13 miles South & 3 West of Ingalls

2 WATER WELL OWNER: Fry Property of Ed Fry Global Positioning Systems (decimal degrees, min. of 4 digits)  
 RR#, St. Address, Box #: P.O. Box 1013 Ag Management  
 City, State ZIP Code: Garden City KS 67846  
 Latitude: \_\_\_\_\_  
 Longitude: \_\_\_\_\_  
 Elevation: \_\_\_\_\_  
 Datum: \_\_\_\_\_  
 Data Collection Method: \_\_\_\_\_

3 MARK WELL'S LOCATION WITH AN "X" IN SECTION BOX:

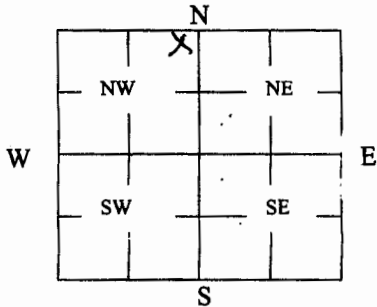

4 DEPTH OF WELL 320 ft.

WELL'S STATIC WATER LEVEL 227 ft.

- WELL WAS USED AS:
- |              |                            |                   |
|--------------|----------------------------|-------------------|
| 1 Domestic   | 5 Public Water Supply      | 9 Dewatering      |
| 2 Irrigation | 6 Oil Field Water Supply   | 10 Monitoring     |
| 3 Feedlot    | 7 Domestic (Lawn & Garden) | 11 Injection Well |
| 4 Industrial | 8 Air Conditioning         | 12 Other _____    |

Was a chemical/bacteriological sample submitted to Department? Yes \_\_\_\_\_ No \_\_\_\_\_

5 TYPE OF BLANK CASING USED:

1 Steel	3 RMP (SR)	5 Wrought	7 Fiberglass	9 Other (Specify below)
2 PVC	4 ABS	6 Asbestos-Cement	8 Concrete Tile	

Blank casing diameter \_\_\_\_\_ in. Was casing pulled? Yes \_\_\_\_\_ No X If yes, how much \_\_\_\_\_  
 Casing height above or below land surface 1 ft. in.

6 GROUT PLUG MATERIAL: 0 Neat cement 2 Cement grout 3 Bentonite 4 Other \_\_\_\_\_

Grout Plug Intervals: From 7' ft. to 17' ft., From 221 ft. to 227 ft., From \_\_\_\_\_ to \_\_\_\_\_ ft.

What is the nearest source of possible contamination:

1 Septic tank	6 Seepage pit	11 Fuel Storage	16 Other (specify below)
2 Sewer lines	7 Pit privy	12 Fertilizer storage	<u>None</u>
3 Watertight sewer lines	8 Sewage lagoon	13 Insecticide storage	
4 Lateral lines	9 Feedyard	14 Abandoned water well	Direction from well? _____
5 Cess pool	10 Livestock pens	15 Oil well/Gas well	How many feet? _____

FROM	TO	PLUGGING MATERIALS	FROM	TO	PLUGGING MATERIALS
<u>7'</u>	<u>17'</u>	<u>Neat Cement</u>			
<u>17'</u>	<u>221</u>	<u>Ident material</u>			
<u>221</u>	<u>227</u>	<u>Bentonite</u>			
<u>227</u>	<u>320</u>	<u>gravel w/ chlorine</u>			

7 CONTRACTOR'S OR LANDOWNER'S CERTIFICATION: This water well was plugged under my jurisdiction and was completed on (mo/day/year) 10/7/16 and this record is true to the best of my knowledge and belief. Kansas Water Well Contractor's License No. 427 This Water Well Record was completed on (mo/day/year) 1-9-17 under the business name of RAK Water Wells LLC by (signature) [Signature]

INSTRUCTIONS: Use typewriter or ballpoint pen. Please press firmly and print clearly. Please fill in blanks, underline or circle the correct answers. Send top three copies to Kansas Department of Health and Environment, Bureau of Water, Geology Section, 1000 SW Jackson St., Ste. 420, Topeka, Kansas 66612-1367. Telephone: 785/296-5522. Send one to Water Well Owner and retain one for your records. Visit us at <http://www.kdheks.gov/geo/waterwells>.