

1 LOCATION OF WATER WELL:	Fraction	Section Number	Township Number	Range Number
County: Sedgwick	NW 1/4 NE 1/4 NE 1/4	1	T 27 S	R 3 E W

Distance and direction from nearest town or city street address of well if located within city?


2 WATER WELL OWNER: Ed Bugner
RR#, St. Address, Box #: 82111 W. 29th N.
City, State, ZIP Code: Colwich, KS 67036 Q11

Board of Agriculture, Division of Water Resources

Application Number

3 LOCATE WELL'S LOCATION WITH AN "X" IN SECTION BOX:

4 DEPTH OF COMPLETED WELL..... 10 ft. ELEVATION:

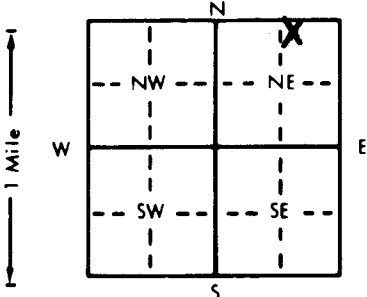

Depth(s) Groundwater Encountered 410 ft. 2. ft. 3. 412810 ft.

WELL'S STATIC WATER LEVEL . . . 70 . . . ft. below land surface measured on mo/day/yr . 11/28/95 .

Est. Yield _____ gpm; Well water was _____ ft. after _____ hours pumping _____ gpm

Bore Hole Diameter. 11 in. to 96 ft., and in. to ft.

WELL WATER TO BE USED AS:

1 Domestic 3 Feedlot 6 Oil field water supply 9 Dewatering 12 Other (Specify below)
2 Irrigation 4 Industrial 7 Lawn and garden only 10 Monitoring well

Was a chemical/bacteriological sample submitted to Department? Yes.....No.....; If yes, mp/day/yr sample was sub

Water Well Disinfected? Yes ☒ No ☒

5] TYPE OF BLANK CASING USED:

5 Wrought iron 8 Concrete tile CASING JOINTS: Glued . . . ~~X~~ . . . Clamped

CASING JOINTS: Glued . . . ~~X~~ . . . Clamped

1 Steel	3 RMP (SR)	6 Asbestos-Cement	9 Other (specify below)	Welded
2 PVC	4 ADS	7 Fiberglass		Threaded


Casing height above land surface. 12 in., weight 2.60 lbs./ft. Wall thickness or gauge No. 160 PSI

TYPE OF SCREEN OR PERFORATION MATERIAL: 7 PVC 10 Asbestos-cement

1 Steel	3 Stainless steel	5 Fiberglass	8 RMP (SR)	11 Other (specify)
2 Brass	4 Galvanized steel	6 Concrete tile	9 ABS	12 None used (open hole)

SCREEN OR PERFORATION OPENINGS ARE: 5 Gauzed wrapped 8 Saw cut 11 None (open hole)

1 Continuous slot 3 Mill slot 6 Wire wrapped 9 Drilled holes

SCREEN-PERFORATED INTERVALS: From 3/2 ft. to 9/2 ft. From _____ ft. to _____ ft.

From 36 ft. to 76 ft., From _____ ft. to _____ ft.

GRAVEL PACK INTERVALS: From 410 ft. to 910 ft. From _____ ft. to _____ ft.
From _____ ft. to _____ ft. From _____ ft. to _____ ft.

		From		ft. to		ft., From		ft. to		ft.	
6	GROUT MATERIAL:	1 Neat cement	2 Cement grout	3 Bentonite	4 Other						

Grout Intervals: From 3 ft. to 90 ft., From _____ ft. to _____ ft., From _____ ft. to _____ ft.

What is the nearest source of possible contamination:


1 Septic tank	4 Lateral lines	7 Pit privy	11 Fuel storage	15 Oil well/Gas well
2 Sewer lines	5 Cess pool	8 <u>Sewage lagoon</u>	12 Fertilizer storage	16 Other (specify below)

3 Watertight sewer lines 6 Seepage pit 9 Feedyard 13 Insecticide storage

Direction from well?		Southwest		How many feet?		160	
FROM	TO	LITHOLOGIC LOG		FROM	TO	PLUGGING INTERVALS	

[illegible]

7 CONTRACTOR'S OR LANDOWNER'S CERTIFICATION: This water well was (1) constructed, (2) reconstructed, or (3) plugged under my jurisdiction and was

completed on (mo/day/year) 11/30/95 and this record is true to the best of my knowledge and belief. Kansas
 Water Well Construction License No. 12-05-95 This Water Well Record is dated 11-30-95

Water Well Contractor's License No. 518 This Water Well Record was completed on (month/day/yr) 12/15
under the business name of Weninger Drilling Inc. by (signature) Karlina Maser

INSTRUCTIONS: Use typewriter or ball point pen. PLEASE PRESS FIRMLY and PRINT clearly. Please fill in blanks, underline or circle the correct answers. Send top three copies to Kansas Department

of Health and Environment, Bureau of Water, Topeka, Kansas 66620-0001. Telephone: 913-296-5545. Send one to WATER WELL OWNER and retain one for your records.