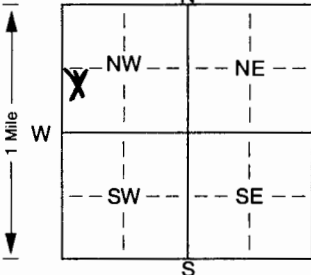


1 LOCATION OF WATER WELL: Fraction <u>SW</u> <u>NW</u> Section Number <u>32</u> Township Number <u>20</u> Range Number <u>3</u> E/W	
County: <u>Sedgwick</u> Distance and direction from nearest town or city street address of well if located within city? <u>144 S. Bluebell - garden plain</u>	
2 WATER WELL OWNER: <u>Scott Schmelzer</u> RR#, St. Address, Box #: <u>150 S. Forestview Ct.</u> City, State, ZIP Code: <u>Wichita, KS 67235</u> Board of Agriculture, Division of Water Resources Application Number:	
3 LOCATE WELL'S LOCATION WITH AN "X" IN SECTION BOX: 	4 DEPTH OF COMPLETED WELL: <u>73</u> ELEVATION: <u>7-3003</u> Depth(s) Groundwater Encountered: <u>10</u> ft. 2. <u>7-3003</u> ft. 3. WELL'S STATIC WATER LEVEL: <u>10</u> ft. <u>X</u> No. <u>X</u> If yes, mo/day/yr sample was submitted Water Well Disinfected? Yes <u>X</u> No <u>X</u>
5 TYPE OF BLANK CASING USED: 1 Steel 3 RMP (SR) 5 Wrought iron 8 Concrete tile CASING JOINTS: Glued <u>X</u> Clamped <u>X</u> 2 PVC 4 ABS 6 Asbestos-Cement 9 Other (specify below) Welded <u>X</u> Blank casing diameter: <u>12</u> in. 
<u>30</u>	
FROM TO LITHOLOGIC LOG	FROM TO PLUGGING INTERVALS
0 2 top soil	
2 18 sand	
18 73 shale	
7 CONTRACTOR'S OR LANDOWNER'S CERTIFICATION: This water well was (1) constructed, (2) reconstructed, or (3) plugged under my jurisdiction and was completed on (mo/day/year) <u>7-30-03</u> and this record is true to the best of my knowledge and belief. Kansas Water Well Contractor's Licence No. <u>318</u> This Water Well Record was completed on (mo/day/yr) <u>7-30-03</u> under the business name of <u>Weninger Drilling Inc.</u> by (signature) <u>Michael Gorge</u>	