


1 LOCATION OF WATER WELL: Fraction SE NW NE Section Number 31 Township Number 27S Range Number 3 EW
 County: Sedgwick

Distance and direction from nearest town or city street address of well if located within city? 723 Doyle - Garden Plain

2 WATER WELL OWNER: Mark Fisher

RR #, St. Address, Box #: _____
 City, State, ZIP Code: _____
 Board of Agriculture, Division of Water Resources
 Application Number: _____

3 MARK WELL'S LOCATION WITH AN "X" IN SECTION BOX:

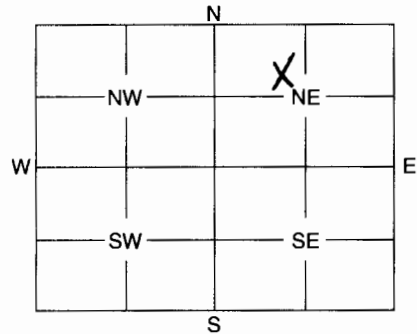

4 DEPTH OF WELL 40 ft.
 WELL'S STATIC WATER LEVEL 15 ft.

WELL WAS USED AS:

- ☒ 1 Domestic 5 Public Water Supply 9 Dewatering
☐ 2 Irrigation 6 Oil Field Water Supply 10 Monitoring Well
☐ 3 Feedlot 7 Domestic (Lawn & Garden) 11 Injection Well
☐ 4 Industrial 8 Air Conditioning 12 Other _____

Was a chemical / bacteriological sample submitted to Department? Yes _____ No X
 If yes, mo/day/yr sample was submitted _____

Water Well Disinfected: Yes X No _____

5 TYPE OF BLANK CASING USED:

- 1 Steel 3 RMP (SR) 5 Wrought 7 Fiberglass 9 Other (Specify below) Galvanized
 2 PVC 4 ABS 6 Asbestos-Cement 8 Concrete Tile

Blank casing diameter 6 in. Was casing pulled? Yes _____ No X If yes, how much _____
 Casing height above or below land surface _____ in.

6 GROUT PLUG MATERIAL: 1 Neat cement 2 Cement grout 3 Bentonite 4 Other _____
 Grout Plug Intervals: From _____ ft. to _____ ft., From _____ ft. to _____ ft., From _____ ft. to _____ ft.

What is the nearest source of possible contamination:

- 1 Septic tank 6 Seepage pit 11 Fuel storage 16 Other (specify below) Inside house
 2 Sewer lines 7 Pit privy 12 Fertilizer storage
 3 Watertight sewer lines 8 Sewage lagoon 13 Insecticide storage
 4 Lateral lines 9 Feedyard 14 Abandoned water well
 5 Cess pool 10 Livestock pens 15 Oil well/Gas well

Direction from well? _____ How many feet? _____

FROM	TO	PLUGGING MATERIALS
<u>40</u>	<u>3</u>	<u>bentonite</u>
<u>3</u>	<u>0</u>	<u>cement</u>

7 CONTRACTOR'S OF LANDOWNER'S CERTIFICATION: This water well was plugged under my jurisdiction and was completed on (mo/day/year) 11-10-03 and this record is true to the best of my knowledge and belief. Kansas Water Well Contractor's License No. 318 This Water Well Record was completed on (mo/day/year) _____ under the business name of Wentz Drilling Inc.
 by (signature) Luckel Carges

INSTRUCTIONS: Use typewriter or ball point pen. Please press firmly and print clearly. Please fill in blanks, underline or circle the correct answers. Send top three copies to Kansas Department of Health and Environment, Bureau of Water, Geology Section, 1000 SW Jackson St., Ste. 420, Topeka, Kansas 66612-1367. Telephone: 785/296-5522. Send one to Water Well Owner and retain one for your records.