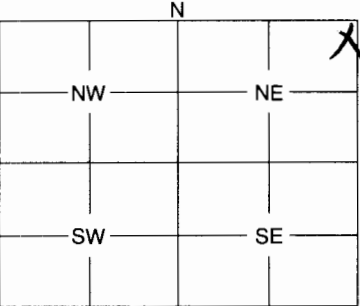


1	LOCATION OF WATER WELL:	Fraction NE NE NE ¼ ¼ ¼	Section 1	Number	Township 27.S	Range 3	EW
County: Sedgewick							

Distance and direction from nearest town or city street address of well if located within city?

2843 N. 219th W.

2	WATER WELL OWNER: Scott Grady		
RR #, St. Address, Box #:		Board of Agriculture, Division of Water Resources	
City, State, ZIP Code :		Application Number:	

3	MARK WELL'S LOCATION WITH AN "X" IN SECTION BOX:	4	DEPTH OF WELL 111 ft.										
		WELL'S STATIC WATER LEVEL 30 ft.											
		WELL WAS USED AS:											
		<table style="width:100%;"> <tr> <td>☒ 1 Domestic</td> <td>☐ 5 Public Water Supply</td> <td>☐ 9 Dewatering</td> </tr> <tr> <td>☐ 2 Irrigation</td> <td>☐ 6 Oil Field Water Supply</td> <td>☐ 10 Monitoring Well</td> </tr> <tr> <td>☐ 3 Feedlot</td> <td>☐ 7 Domestic (Lawn & Garden)</td> <td>☐ 11 Injection Well</td> </tr> <tr> <td>☐ 4 Industrial</td> <td>☐ 8 Air Conditioning</td> <td>☐ 12 Other</td> </tr> </table>		☒ 1 Domestic	☐ 5 Public Water Supply	☐ 9 Dewatering	☐ 2 Irrigation	☐ 6 Oil Field Water Supply	☐ 10 Monitoring Well	☐ 3 Feedlot	☐ 7 Domestic (Lawn & Garden)	☐ 11 Injection Well	☐ 4 Industrial
☒ 1 Domestic	☐ 5 Public Water Supply	☐ 9 Dewatering											
☐ 2 Irrigation	☐ 6 Oil Field Water Supply	☐ 10 Monitoring Well											
☐ 3 Feedlot	☐ 7 Domestic (Lawn & Garden)	☐ 11 Injection Well											
☐ 4 Industrial	☐ 8 Air Conditioning	☐ 12 Other											
Was a chemical / bacteriological sample submitted to Department? Yes No X													
If yes, mo/day/yr sample was submitted													
Water Well Disinfected: Yes X No													

5	TYPE OF BLANK CASING USED:												
<table style="width:100%;"> <tr> <td>☒ 1 Steel</td> <td>☐ 3 RMP (SR)</td> <td>☐ 5 Wrought</td> <td>☐ 7 Fiberglass</td> <td>☐ 9 Other (Specify below)</td> </tr> <tr> <td>☐ 2 PVC</td> <td>☐ 4 ABS</td> <td>☐ 6 Asbestos-Cement</td> <td>☐ 8 Concrete Tile</td> <td></td> </tr> </table>				☒ 1 Steel	☐ 3 RMP (SR)	☐ 5 Wrought	☐ 7 Fiberglass	☐ 9 Other (Specify below)	☐ 2 PVC	☐ 4 ABS	☐ 6 Asbestos-Cement	☐ 8 Concrete Tile	
☒ 1 Steel	☐ 3 RMP (SR)	☐ 5 Wrought	☐ 7 Fiberglass	☐ 9 Other (Specify below)									
☐ 2 PVC	☐ 4 ABS	☐ 6 Asbestos-Cement	☐ 8 Concrete Tile										
Blank casing diameter 5 in. Was casing pulled? Yes No X If yes, how much													
Casing height above or below land surface in.													

6	GROUT PLUG MATERIAL: ☐ 1 Neat cement ☒ 2 Cement grout ☐ 3 Bentonite ☐ 4 Other																				
Grout Plug Intervals: From 20 ft. to 0 ft., From ft. to ft., From ft. to ft.																					
What is the nearest source of possible contamination:																					
<table style="width:100%;"> <tr> <td>☐ 1 Septic tank</td> <td>☐ 6 Seepage pit</td> <td>☐ 11 Fuel storage</td> <td>☐ 15 Other (specify below)</td> </tr> <tr> <td>☐ 2 Sewer lines</td> <td>☐ 7 Pit privy</td> <td>☐ 12 Fertilizer storage</td> <td rowspan="3">Inside house</td> </tr> <tr> <td>☐ 3 Watertight sewer lines</td> <td>☐ 8 Sewage lagoon</td> <td>☐ 13 Insecticide storage</td> </tr> <tr> <td>☐ 4 Lateral lines</td> <td>☐ 9 Feedyard</td> <td>☐ 14 Abandoned water well</td> </tr> <tr> <td>☐ 5 Cess pool</td> <td>☐ 10 Livestock pens</td> <td>☐ 15 Oil well/Gas well</td> <td></td> </tr> </table>				☐ 1 Septic tank	☐ 6 Seepage pit	☐ 11 Fuel storage	☐ 15 Other (specify below)	☐ 2 Sewer lines	☐ 7 Pit privy	☐ 12 Fertilizer storage	Inside house	☐ 3 Watertight sewer lines	☐ 8 Sewage lagoon	☐ 13 Insecticide storage	☐ 4 Lateral lines	☐ 9 Feedyard	☐ 14 Abandoned water well	☐ 5 Cess pool	☐ 10 Livestock pens	☐ 15 Oil well/Gas well	
☐ 1 Septic tank	☐ 6 Seepage pit	☐ 11 Fuel storage	☐ 15 Other (specify below)																		
☐ 2 Sewer lines	☐ 7 Pit privy	☐ 12 Fertilizer storage	Inside house																		
☐ 3 Watertight sewer lines	☐ 8 Sewage lagoon	☐ 13 Insecticide storage																			
☐ 4 Lateral lines	☐ 9 Feedyard	☐ 14 Abandoned water well																			
☐ 5 Cess pool	☐ 10 Livestock pens	☐ 15 Oil well/Gas well																			
Direction from well? How many feet?																					

FROM	TO	PLUGGING MATERIALS
84	20	gravel
20	0	cement

7	CONTRACTOR'S OF LANDOWNER'S CERTIFICATION: This water well was plugged under my jurisdiction and was completed on (mo/day/year) 5-12-04 and this record is true to the best of my knowledge and belief. Kansas Water Well Contractor's License No. 318 This Water Well Record was completed on (mo/day/year) 5-12-04 under the business name of Weninger Drilling Inc by (signature) Dickie Hopp		
---	---	--	--

INSTRUCTIONS: Use typewriter or ball point pen. Please press firmly and print clearly. Please fill in blanks, underline or circle the correct answers. Send top three copies to Kansas Department of Health and Environment, Bureau of Water, Geology Section, 1000 SW Jackson St., Ste. 420, Topeka, Kansas 66612-1367. Telephone: 785/296-5522. Send one to Water Well Owner and retain one for your records.