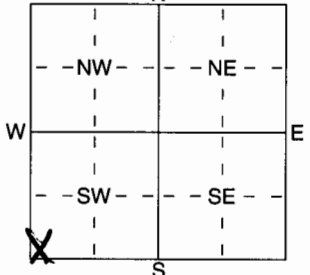


1 LOCATION OF WATER WELL: Fraction <u>80 8W 8W 1/4</u> Section Number <u>14</u> Township Number <u>T 270 S</u> Range Number <u>R 3 EW</u>	
Distance and direction from nearest town or city street address of well if located within city? <u>490 N. 247th W.</u>	
2 WATER WELL OWNER: <u>Dwayne & Melissa Horing</u> RR#, St. Address, Box # : City, State, ZIP Code : Board of Agriculture, Division of Water Resources Application Number:	
3 LOCATE WELL'S LOCATION WITH AN "X" IN SECTION BOX: 	4 DEPTH OF COMPLETED WELL <u>80</u> ft. ELEVATION: <u>247</u> ft. Depth(s) Groundwater Encountered <u>24</u> ft. 2 <u>247</u> ft. 3 <u>247</u> ft. WELL'S STATIC WATER LEVEL <u>24</u> ft. below land surface measured on mo/day/yr <u>9/12/04</u> Pump test data: Well water was _____ ft. after _____ hours pumping _____ gpm Est. Yield <u>20</u> gpm: Well water was _____ ft. after _____ hours pumping _____ gpm WELL WATER TO BE USED AS: <table border="0" style="width:100%;"> <tr> <td>1 Domestic</td> <td>3 Feedlot</td> <td>6 Oil field water supply</td> <td>8 Air conditioning</td> <td>11 Injection well</td> </tr> <tr> <td>2 Irrigation</td> <td>4 Industrial</td> <td>7 Domestic (lawn & garden)</td> <td>9 Dewatering</td> <td>12 Other (Specify below)</td> </tr> </table>	1 Domestic	3 Feedlot	6 Oil field water supply	8 Air conditioning	11 Injection well	2 Irrigation	4 Industrial	7 Domestic (lawn & garden)	9 Dewatering	12 Other (Specify below)																																			
1 Domestic	3 Feedlot	6 Oil field water supply	8 Air conditioning	11 Injection well	
2 Irrigation	4 Industrial	7 Domestic (lawn & garden)	9 Dewatering	12 Other (Specify below)	
5 TYPE OF BLANK CASING USED: <table border="0" style="width:100%;"> <tr> <td>1 Steel</td> <td>3 RMP (SR)</td> <td>5 Wrought iron</td> <td>8 Concrete tile</td> <td>CASING JOINTS: Glued <u>X</u> Clamped _____</td> </tr> <tr> <td>2 PVC</td> <td>4 ABS</td> <td>6 Asbestos-Cement</td> <td>9 Other (specify below)</td> <td>Welded _____</td> </tr> <tr> <td></td> <td></td> <td>7 Fiberglass</td> <td></td> <td>Threaded _____</td> </tr> </table> Blank casing diameter <u>5</u> in. to <u>35</u> ft., Dia <u>2.40</u> in. to _____ ft., Dia _____ in. to _____ ft. Casing height above land surface <u>12</u> in., weight _____ lbs./ft. Wall thickness or gauge No. <u>100psi</u> TYPE OF SCREEN OR PERFORATION MATERIAL: <table border="0" style="width:100%;"> <tr> <td>1 Steel</td> <td>3 Stainless Steel</td> <td>5 Fiberglass</td> <td>7 PVC</td> <td>10 Asbestos-Cement</td> </tr> <tr> <td>2 Brass</td> <td>4 Galvanized Steel</td> <td>6 Concrete tile</td> <td>8 RMP (SR)</td> <td>11 Other (Specify)</td> </tr> <tr> <td></td> <td></td> <td></td> <td>9 ABS</td> <td>12 None used (open hole)</td> </tr> </table> SCREEN OR PERFORATION OPENINGS ARE: <table border="0" style="width:100%;"> <tr> <td>1 Continuous slot</td> <td>3 Mill slot</td> <td>5 Gauzed wrapped</td> <td>8 Saw cut</td> <td>11 None (open hole)</td> </tr> <tr> <td>2 Louvered shutter</td> <td>4 Key punched</td> <td>6 Wire wrapped</td> <td>9 Drilled holes</td> <td></td> </tr> <tr> <td></td> <td></td> <td>7 Torch cut</td> <td>10 Other (specify)</td> <td>_____ ft.</td> </tr> </table> SCREEN-PERFORATED INTERVALS: From <u>35</u> ft. to <u>80</u> ft., From _____ ft. to _____ ft. From <u>24</u> ft. to <u>80</u> ft., From _____ ft. to _____ ft. GRAVEL PACK INTERVALS: From _____ ft. to _____ ft., From _____ ft. to _____ ft. From _____ ft. to _____ ft., From _____ ft. to _____ ft.		1 Steel	3 RMP (SR)	5 Wrought iron	8 Concrete tile	CASING JOINTS: Glued <u>X</u> Clamped _____	2 PVC	4 ABS	6 Asbestos-Cement	9 Other (specify below)	Welded _____			7 Fiberglass		Threaded _____	1 Steel	3 Stainless Steel	5 Fiberglass	7 PVC	10 Asbestos-Cement	2 Brass	4 Galvanized Steel	6 Concrete tile	8 RMP (SR)	11 Other (Specify)				9 ABS	12 None used (open hole)	1 Continuous slot	3 Mill slot	5 Gauzed wrapped	8 Saw cut	11 None (open hole)	2 Louvered shutter	4 Key punched	6 Wire wrapped	9 Drilled holes				7 Torch cut	10 Other (specify)	_____ ft.
1 Steel	3 RMP (SR)	5 Wrought iron	8 Concrete tile	CASING JOINTS: Glued <u>X</u> Clamped _____	
2 PVC	4 ABS	6 Asbestos-Cement	9 Other (specify below)	Welded _____	
		7 Fiberglass		Threaded _____	
1 Steel	3 Stainless Steel	5 Fiberglass	7 PVC	10 Asbestos-Cement	
2 Brass	4 Galvanized Steel	6 Concrete tile	8 RMP (SR)	11 Other (Specify)	
			9 ABS	12 None used (open hole)	
1 Continuous slot	3 Mill slot	5 Gauzed wrapped	8 Saw cut	11 None (open hole)	
2 Louvered shutter	4 Key punched	6 Wire wrapped	9 Drilled holes	
		7 Torch cut	10 Other (specify)	_____ ft.	
6 GROUT MATERIAL: <u>1</u> Neat cement <u>2</u> Cement grout <u>3</u> Bentonite <u>4</u> Other _____ Grout intervals: From <u>3</u> ft. to <u>24</u> ft., From _____ ft. to _____ ft., From _____ ft. to _____ ft. What is the nearest source of possible contamination: <table border="0" style="width:100%;"> <tr> <td>1 Septic tank</td> <td>4 Lateral lines</td> <td>7 Pit privy</td> <td>10 Livestock pens</td> <td>14 Abandoned water well</td> </tr> <tr> <td>2 Sewer lines</td> <td>5 Cess pool</td> <td>8 Sewage lagoon</td> <td>11 Fuel storage</td> <td>15 Oil well/Gas well</td> </tr> <tr> <td>3 Watertight sewer lines</td> <td>6 Seepage pit</td> <td>9 Feedyard</td> <td>12 Fertilizer storage</td> <td>16 Other (specify below)</td> </tr> <tr> <td></td> <td></td> <td></td> <td>13 Insecticide storage</td> <td><u>Open field</u></td> </tr> </table> Direction from well? _____ How many feet? _____		1 Septic tank	4 Lateral lines	7 Pit privy	10 Livestock pens	14 Abandoned water well	2 Sewer lines	5 Cess pool	8 Sewage lagoon	11 Fuel storage	15 Oil well/Gas well	3 Watertight sewer lines	6 Seepage pit	9 Feedyard	12 Fertilizer storage	16 Other (specify below)				13 Insecticide storage	<u>Open field</u>																									
1 Septic tank	4 Lateral lines	7 Pit privy	10 Livestock pens	14 Abandoned water well	
2 Sewer lines	5 Cess pool	8 Sewage lagoon	11 Fuel storage	15 Oil well/Gas well	
3 Watertight sewer lines	6 Seepage pit	9 Feedyard	12 Fertilizer storage	16 Other (specify below)	
			13 Insecticide storage	<u>Open field</u>	
<table border="1" style="width:100%; border-collapse: collapse;"> <thead> <tr> <th>FROM</th> <th>TO</th> <th>LITHOLOGIC LOG</th> <th>FROM</th> <th>TO</th> <th>PLUGGING INTERVALS</th> </tr> </thead> <tbody> <tr> <td><u>0</u></td> <td><u>3</u></td> <td><u>topsoil</u></td> <td></td> <td></td> <td></td> </tr> <tr> <td><u>3</u></td> <td><u>18</u></td> <td><u>clay</u></td> <td></td> <td></td> <td></td> </tr> <tr> <td><u>18</u></td> <td><u>30</u></td> <td><u>sand/clay</u></td> <td></td> <td></td> <td></td> </tr> <tr> <td><u>30</u></td> <td><u>80</u></td> <td><u>shale</u></td> <td></td> <td></td> <td></td> </tr> </tbody> </table>		FROM	TO	LITHOLOGIC LOG	FROM	TO	PLUGGING INTERVALS	<u>0</u>	<u>3</u>	<u>topsoil</u>				<u>3</u>	<u>18</u>	<u>clay</u>				<u>18</u>	<u>30</u>	<u>sand/clay</u>				<u>30</u>	<u>80</u>	<u>shale</u>																		
FROM	TO	LITHOLOGIC LOG	FROM	TO	PLUGGING INTERVALS	
<u>0</u>	<u>3</u>	<u>topsoil</u>	
<u>3</u>	<u>18</u>	<u>clay</u>	
<u>18</u>	<u>30</u>	<u>sand/clay</u>	
<u>30</u>	<u>80</u>	<u>shale</u>	
7 CONTRACTOR'S OR LANDOWNER'S CERTIFICATION: This water well was (1) constructed, (2) reconstructed, or (3) plugged under my jurisdiction and was completed on (mo/day/year) <u>9/12/04</u> and this record is true to the best of my knowledge and belief. Kansas Water Well Contractor's Licence No. <u>318</u> This Water Well Record was completed on (mo/day/yr) <u>9/30/04</u> under the business name of <u>Woringer Drilling Inc</u> by (signature) <u>Dickie Clark</u>	

INSTRUCTIONS: Use typewriter or ball point pen. PLEASE PRESS FIRMLY and PRINT clearly. Please fill in blanks, underline or circle the correct answers. Send top three copies to Kansas Department of Health and Environment, Bureau of Water, Geology Section, 1000 S.W. Jackson St., Suite 420, Topeka, Kansas 66612-1367. Telephone 785-296-5522. Send one to WATER WELL OWNER and retain one for your records. Fee of \$5.00 for each constructed well.

RECEIVED

OCT 04 2004

BUREAU OF WATER