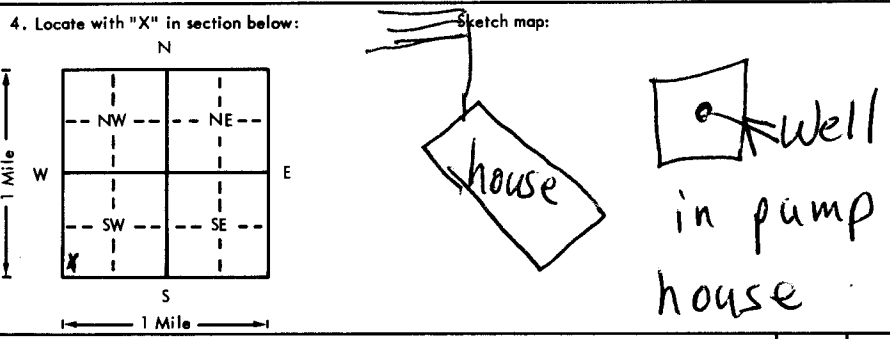


USE TYPEWRITER OR BALL
POINT PEN-PRESS FIRMLY,
PRINT CLEARLY.

WATER WELL RECORD
KSA 82a-1201-1215

Kansas Department of Health and
Environment-Division of Environment
(Water well Contractors)
Topeka, Kansas 66620

1. Location of well:		County <u>Sedg.</u>	Fraction <u>SW 1/4 SW 1/4 SW 1/4</u>	Section number <u>6</u>	Township number <u>T 27 S</u>	Range number <u>R 3 E</u>
2. Distance and direction from nearest town or city: <u>4 mile No. and 1 W. Garden Plain KS.</u>				3. Owner of well: <u>Ed Helton Jr.</u> R.R. or street: <u>RE Garden Plain KS 67050</u> City, state, zip code: <u>Garden Plain KS 67050</u>		
4. Locate with "X" in section below: 				6. Bore hole dia. <u>9 3/4</u> in. Completion date <u>4/6/76</u> Well depth <u>25</u> ft.		
5. Type and color of material				7. ☒ Cable tool ☒ Rotary ☐ Driven ☐ Dug ☐ Hollow rod ☐ Jetted ☐ Bored ☐ Reverse rotary		
				8. Use: ☒ Domestic ☐ Public supply ☐ Industry ☐ Irrigation ☐ Air conditioning ☐ Stock ☐ Lawn ☐ Oil field water ☐ Other		
				9. Casing: Material <u>PPE</u> Height: Above or below Threaded ☐ Welded ☒ Surface <u>13</u> in. RMP ☐ PVC ☒ Weight <u>231</u> lbs./ft. Dia. <u>5</u> in. to <u>25</u> ft. depth Wall Thickness: inches or Dia. <u>5</u> in. to <u>25</u> ft. depth gage No. <u>200</u>		
				10. Screen: Manufacturer's name <u>J & L</u> Type <u>Plastic</u> Dia. <u>5 in</u> Slot/gauze <u>1/16</u> Length <u>30 ft</u> Set between <u>45</u> ft. and <u>75</u> ft. Gravel pack? <u>Yes</u> Size range of material <u>3/8</u>		
				11. Static water level: <u>40</u> ft. below land surface Date <u>1-12-76</u>		
				12. Pumping level below land surfaces: <u>65</u> ft. after <u>1/2</u> hrs. pumping <u>7</u> g.p.m. <u> </u> ft. after <u> </u> hrs. pumping <u> </u> g.p.m. Estimated maximum yield <u>10</u> g.p.m.		
				13. Water sample submitted: <u> </u> mo./day/yr. <u> </u> Yes ☒ No <u> </u> Date <u> </u>		
				14. Well head completion: <u> </u> Pitless adapter <u>12</u> Inches above grade		
				15. Well grouted? <u>Yes</u> With: <u>Neat cement</u> ☒ Bentonite ☐ Concrete ☐ Depth: From <u>0</u> ft. to <u>10</u> ft.		
				16. Nearest source of possible contamination: <u>100</u> ft. Direction <u>West</u> Type <u>Septic</u> Well disinfected upon completion? ☒ Yes ☐ No		
				17. Pump: <u>Not installed</u> Manufacturer's name <u>Watney</u> Model number <u>1807</u> HP <u>1/2</u> Volts <u>230</u> Length of drop pipe <u>65</u> ft. capacity <u>18</u> g.p.m. Type: ☒ Submersible ☐ Turbine ☐ Jet ☐ Reciprocating ☐ Centrifugal ☐ Other		
18. Elevation:		19. Remarks: <u>Customer has poured his own 4x4x4 slab at grade.</u>		20. Water well contractor's certification: This well was drilled under my jurisdiction and this report is true to the best of my knowledge and belief. <u>Weninger Drilling</u> 318 Business name <u>Colwick K.</u> License No. <u> </u> Address <u> </u> Signed <u>James Weninger</u> Date <u>4/2/76</u> Authorized representative		

Forward the white, blue and pink copies to the Department of Health and Environment

Form WWC-5