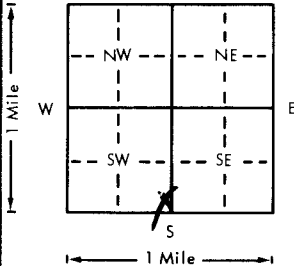
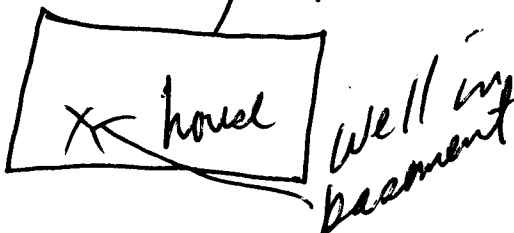


USE TYPEWRITER OR BALL
POINT PEN-PRESS FIRMLY,
PRINT CLEARLY.

WATER WELL RECORD
KSA 82a-1201-1215

Kansas Department of Health and
Environment-Division of Environment
(Water well Contractors)
Topeka, Kansas 66620

1. Location of well:		County <u>Sedgwick</u>	Fraction <u>SE 1/4 SE 1/4 SW 1/4</u>	Section number <u>11</u>	Township number <u>T 27 S</u>	Range number <u>R 3 E</u>
2. Distance and direction from nearest town or city: <u>3 No 3h E Garden Plain</u>		3. Owner of well: <u>Robert Meyer Const</u>		R.R. or street: <u>Garden Plain KS</u>		
Street address of well location if in city:		City, state, zip code: <u>67950</u>				
4. Locate with "X" in section below:		Sketch map:		6. Bore hole dia. <u>11</u> in. Completion date <u>8/29/78</u>		
				Well depth <u>77</u> ft.		
5. Type and color of material		From		To		7. ☒ Cable tool ☒ Rotary ☐ Driven ☐ Dug
<u>Top soil</u>		<u>0</u>		<u>2</u>		☐ Hollow rod ☐ Jetted ☐ Bored ☐ Reverse rotary
<u>red clay.</u>		<u>2</u>		<u>20</u>		8. Use: ☒ Domestic ☐ Public supply ☐ Industry
<u>Gray-blue clay.</u>		<u>20</u>		<u>30</u>		☐ Irrigation ☐ Air conditioning ☐ Stock
<u>Red shale</u>		<u>30</u>		<u>60</u>		☐ Lawn ☐ Oil field water ☐ Other
<u>blue-green shale</u>		<u>60</u>		<u>77</u>		9. Casing: Material <u>Steel</u> Height: <u>12</u> Above or below
						Threaded ☐ Welded ☒ Surface <u>12</u> in.
						RMP ☒ PV ☐ Weight <u>1.50</u> lbs./ft.
						Dia. <u>5</u> in. to <u>77</u> ft. depth Wall Thickness: inches or
						Dia. <u>5</u> in. to <u>77</u> ft. depth gage No. <u>200</u>
						10. Screen: Manufacturer's name <u>Sunflower</u>
						Type <u>208</u> Dia. <u>5</u> in.
						Slot gauge <u>1/16</u> Length <u>40</u> ft.
						Set between <u>37</u> ft. and <u>77</u> ft.
						Gravel pack <u>yes</u> Size range of material <u>3/8</u>
						11. Static water level: <u>25</u> ft. below land surface Date <u>8/29/78</u>
						12. Pumping level below land surfaces:
						<u>35</u> ft. after <u>12</u> hrs. pumping <u>12</u> g.p.m.
						<u>35</u> ft. after <u>12</u> hrs. pumping <u>12</u> g.p.m.
						Estimated maximum yield <u>20-25</u> g.p.m.
						13. Water sample submitted: <u>yes</u> No <u>no</u> Date <u>8/29/78</u>
						14. Well head completion: <u>12</u> inches above grade
						☐ Pitless adapter ☒ Pitless adapter
						15. Well grouted? <u>yes</u>
						With: ☐ Neat cement ☐ Bentonite ☒ Concrete
						Depth: From <u>6</u> ft. to <u>16</u> ft.
						16. Nearest source of possible contamination: <u>100</u> ft. Direction <u>NE</u> Type <u>Septic</u>
						Well disinfected upon completion? ☒ Yes ☐ No
						17. Pump: ☒ Not installed
						Manufacturer's name <u>Waringer Pully</u>
						Model number <u>318</u> HP <u>3</u> Volts <u>115</u>
						Length of drop pipe <u>11</u> ft. capacity <u>11</u> g.p.m.
						Type: ☐ Submersible ☐ Turbine
						☐ Jet ☐ Reciprocating
						☐ Centrifugal ☐ Other
18. Elevation:		19. Remarks:		20. Water well contractor's certification:		
Topography: ☒ Hill ☐ Slope ☐ Upland ☐ Valley				This well was drilled under my jurisdiction and this report is true to the best of my knowledge and belief.		
				Business name <u>Waringer Pully</u> License No. <u>318</u>		
				Address <u>Sedgwick</u>		
				Signature <u>Joe Waringer</u> Date <u>8/29/78</u>		
				Authorized representative		

Forward the white, blue and pink copies to the Department of Health and Environment

Form WWC-5