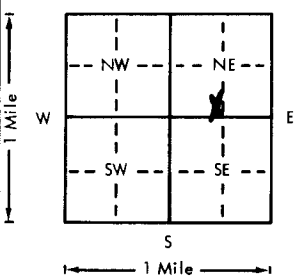
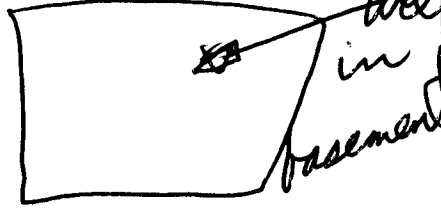


USE TYPEWRITER OR BALL
POINT PEN-PRESS FIRMLY,
PRINT CLEARLY.

WATER WELL RECORD
KSA 82a-1201-1215

Kansas Department of Health and
Environment-Division of Environment
(Water well Contractors)
Topeka, Kansas 66620

1. Location of well:		County <u>Sedgwick</u>	Fraction <u>SE 1/4 SW 1/4 NE 1/4</u>	Section number <u>12</u>	Township number <u>27</u>	Range number <u>3</u>
2. Distance and direction from nearest town or city:		3. Owner of well: <u>Kenneth Kruse</u>		R.R. or street: <u>21821 Argosia Ct.</u>		
4. Locate with "X" in section below:		Sketch map:		6. Bore hole dia. <u>6</u> in. Completion date <u>3/30/78</u>		
				Well depth <u>26</u> ft.		
5. Type and color of material		From		To		7. Cable tool ☒ Rotary ☐ Driven ☐ Dug
<u>Top soil.</u>		<u>0.8</u>				☐ Hollow rod ☐ Jetted ☐ Bored ☐ Reverse rotary
<u>Brown red clay.</u>		<u>8.26</u>				8. Use: ☒ Domestic ☐ Public supply ☐ Industry
<u>Blue green shale</u>		<u>26</u>		<u>40</u>		☐ Irrigation ☐ Air conditioning ☐ Stock
<u>Charcoal shale</u>		<u>40</u>		<u>80</u>		☐ Lawn ☐ Oil field water ☐ Other
						9. Casing: Material <u>Styrene</u> Height <u>12</u> Above or below
						Threaded ☐ Welded ☒ Surface <u>12</u> in.
						RMP <u>5</u> PVC <u>1.50</u> Weight <u>1.50</u> lbs./ft.
						Dia. <u>5</u> in. to <u>80</u> ft. depth Wall Thickness: inches or
						Dia. <u>5</u> in. to <u>80</u> ft. depth gage No. <u>200</u>
						10. Screen: Manufacturer's name <u>Sunflower</u>
						Type <u>200</u> Dia. <u>5</u> in.
						Set between <u>30</u> ft. and <u>80</u> ft.
						Gravel pack? <u>Yes</u> Size range of material <u>3/8</u>
						11. Static water level: <u>11</u> ft. below land surface Date <u>3/30/78</u>
						12. Pumping level below land surfaces:
						<u>40</u> ft. after <u>1/2</u> hrs. pumping <u>15</u> g.p.m.
						<u>40</u> ft. after <u>1</u> hrs. pumping <u>15</u> g.p.m.
						Estimated maximum yield <u>25</u> g.p.m.
						13. Water sample submitted: <u>Yes</u> ☒ No ☐ Date <u>3/30/78</u>
						14. Well head completion: <u>12</u> inches above grade
						<u>Pitless adapter</u>
						15. Well grouted? <u>Yes</u>
						With: <u>Neat cement</u> ☐ Bentonite ☒ Concrete ☐
						Depth: From <u>3</u> ft. to <u>12</u> ft.
						16. Nearest source of possible contamination: <u>300</u> ft. Direction <u>E</u> Type <u>Creek</u>
						Well disinfected upon completion? ☒ Yes ☐ No
						17. Pump: ☒ Not installed
						Manufacturer's name <u>Wagner</u>
						Model number <u>318</u> HP <u>3</u> Volts <u>115</u>
						Length of drop pipe <u>318</u> ft. capacity <u>3</u> g.p.m.
						Type: ☐ Submersible ☐ Turbine
						☐ Jet ☐ Reciprocating
						☐ Centrifugal ☐ Other
18. Elevation:		19. Remarks:		20. Water well contractor's certification:		
Topography: ☒ Hill ☐ Slope ☐ Upland ☐ Valley				This well was drilled under my jurisdiction and this report is true to the best of my knowledge and belief.		
				Authorized representative		

Forward the white, blue and pink copies to the Department of Health and Environment

Form WWC-5