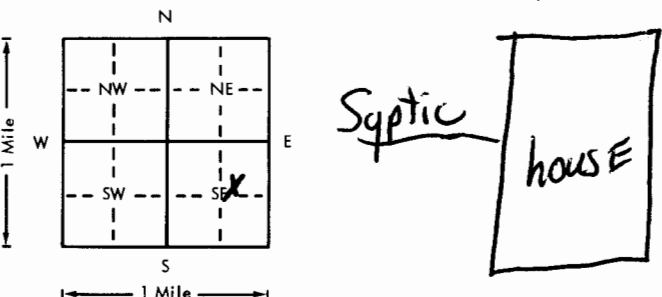


USE TYPEWRITER OR BALL
POINT PEN-PRESS FIRMLY,
PRINT CLEARLY.

WATER WELL RECORD
KSA 82a-1201-1215

Kansas Department of Health and
Environment-Division of Environment
(Water well Contractors)
Topeka, Kansas 66620

1. Location of well:	County <u>Sedgwick</u>	Fraction <u>SW 1/4 NE 1/4 SE 1/4</u>	Section number <u>12</u>	Township number <u>T 27 S</u>	Range number <u>R 3 E</u>
2. Distance and direction from nearest town or city: <u>1 West 3 1/2 No Goddard KS.</u>			3. Owner of well: <u>Mike Kampling</u> R.R. or street: <u>16171 W. Kelleys</u> City, state, zip code: <u>Goddard KS 67052</u>		
4. Locate with "X" in section below: 			6. Bore hole dia. <u>8 1/2</u> in. Completion date <u>1/31/78</u> Well depth <u>81</u> ft.		
5. Type and color of material			7. ☒ Cable tool ☒ Rotary ☐ Driven ☐ Dug ☐ Hollow ☐ Jetted ☐ Bored ☐ Reverse rotary		
			8. Use: ☒ Domestic ☐ Public supply ☐ Industry ☐ Irrigation ☐ Air conditioning ☐ Stock ☐ Lawn ☐ Oil field water ☐ Other		
			9. Casing: Material <u>PVC</u> Height <u>Above</u> or below Threaded ☐ Welded ☒ Surface <u>12</u> in. RMP ☐ PVC ☒ Weight <u>2.76</u> lbs./ft. Dia. <u>5</u> in. to <u>8 1/2</u> in. depth Wall Thickness: inches or Dia. <u>5</u> in. to <u>8 1/2</u> in. depth gage No. <u>258</u>		
			10. Screen: Manufacturer's name <u>M.P.E.</u> Type <u>PVC</u> Dia. <u>5 in</u> Slot gauge <u>1/16</u> Length <u>30 ft</u> Set between <u>51</u> ft. and <u>810</u> ft. ft. and <u>810</u> ft. Gravel pack? ☒ Size range of material <u>3/8</u>		
			11. Static water level: <u>31</u> ft. below land surface Date <u>1/31/78</u> mo./day/yr.		
(Use a second sheet if needed)			12. Pumping level below land surfaces: <u>37</u> ft. after <u>1/2</u> hrs. pumping <u>10</u> g.p.m. ft. after <u>1</u> hrs. pumping <u>10</u> g.p.m. Estimated maximum yield <u>15-20</u> g.p.m.		
			13. Water sample submitted: <u>X</u> Yes <u>X</u> No Date <u>1/31/78</u> mo./day/yr.		
			14. Well head completion: <u>12</u> Pitless adapter <u>12</u> inches above grade		
			15. Well grouted? ☒ With: <u>Neat cement</u> ☐ Bentonite ☒ Concrete Depth: From <u>3</u> ft. to <u>13</u> ft.		
			16. Nearest source of possible contamination: ft. <u>80</u> Direction <u>West</u> Type <u>Septic</u> Well disinfected upon completion? ☒ Yes ☐ No		
(Use a second sheet if needed)			17. Pump: ☒ Not installed Manufacturer's name _____ Model number _____ HP _____ Volts _____ Length of drop pipe _____ ft. capacity _____ g.p.m. Type: ☐ Submersible ☐ Turbine ☐ Jet ☐ Reciprocating ☐ Centrifugal ☐ Other		
			18. Elevation:		
			19. Remarks: <u>Customer agrees to have 4x4x4 slab poured around casing at grade and realizes it is State Regulation</u> <u>Signed X Michael J. Kampling</u>		
			20. Water well contractor's certification: This well was drilled under my jurisdiction and this report is true to the best of my knowledge and belief. <u>Weninger Drilling</u> <u>318</u> Business name License No. Address <u>Polwich</u> Signed <u>Jerome Weninger</u> <u>1/31/78</u> Authorized representative		
			18. Elevation:		

Forward the white, blue and pink copies to the Department of Health and Environment

Form WWC-5