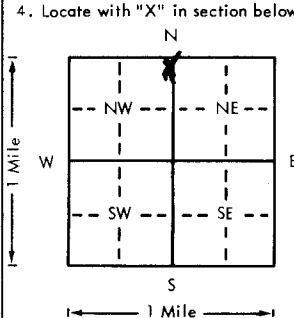


USE TYPEWRITER OR BALL
POINT PEN-PRESS FIRMLY,
PRINT CLEARLY.

WATER WELL RECORD
KSA 82a-1201-1215

Kansas Department of Health and
Environment-Division of Environment
(Water well Contractors)
Topeka, Kansas 66620

1. Location of well:		County <u>Edgwick</u>	Fraction <u>NE 1/4 NE 1/4 NW 1/4</u>	Section number <u>17</u>	Township number <u>T 27 S</u>	Range number <u>R 3 E</u>
2. Distance and direction from nearest town or city: <u>3 No 1/2 E Garden Plain KS</u>			3. Owner of well: <u>Herb Boehlke</u> R.R. or street: <u>mt Hope</u> City, state, zip code: <u>67108</u>			
4. Locate with "X" in section below: 			6. Bore hole dia. <u>1 1/2</u> in. Completion date <u>8/28/78</u> Well depth <u>80</u> ft.			
5. Type and color of material			7. ☒ Cable tool ☒ Rotary ☐ Driven ☐ Dug ☐ Hollow rod ☐ Jetted ☐ Bored ☐ Reverse rotary			
From To			8. Use: ☒ Domestic ☐ Public supply ☐ Industry ☐ Irrigation ☐ Air conditioning ☐ Stock ☐ Lawn ☐ Oil field water ☐ Other			
Top soil 0 3			9. Casing: Material <u>Steel</u> Height <u>0</u> Above or below Threaded ☒ Welded ☒ Surface <u>1 1/2</u> in. RMP ☒ PVC ☐ Weight <u>1.50</u> lbs./ft. Dia. <u>5</u> in. to <u>80</u> ft. depth Wall thickness: inches or Dia. <u>5</u> in. to <u>80</u> ft. depth gage No. <u>200</u>			
blue-gray clay. 3 14			10. Screen: Manufacturer's name <u>Sunflower</u> Type <u>200</u> Dia. <u>5</u> in. Slot gauge <u>1 1/16</u> Length <u>40</u> Set between <u>40</u> ft. and <u>80</u> ft. Gravel pack? <u>yes</u> Size range of material <u>3/8</u>			
Gray clay 14 30			11. Static water level: <u>28</u> ft. below land surface Date <u>8/28/78</u>			
fine sand & white 30 40			12. Pumping level below land surfaces: <u>48</u> ft. after <u>12</u> hrs. pumping <u>10</u> g.p.m. <u>48</u> ft. after <u>12</u> hrs. pumping <u>10</u> g.p.m. Estimated maximum yield <u>10-20</u> g.p.m.			
red shale 40 50			13. Water sample submitted: <u>no</u> mo./day/yr.			
blue green shale 50 56			14. Well head completion: <u>12</u> inches above grade			
red shale 56 80			15. Well grouted? <u>yes</u> With: <u>Neat cement</u> ☐ Bentonite ☒ Concrete Depth: From <u>3</u> ft. to <u>13</u> ft.			
			16. Nearest source of possible contamination: <u>100</u> ft. Direction <u>No</u> Type <u>Septic</u> Well disinfected upon completion? ☒ Yes ☐ No			
			17. Pump: ☒ Not installed			
			Manufacturer's name <u>X</u>			
			Model number <u> </u> HP <u> </u> Volts <u> </u>			
			Length of drop pipe <u> </u> ft. capacity <u> </u> g.p.m.			
			Type:			
			☐ Submersible ☐ Turbine			
			☐ Jet ☐ Reciprocating			
			☐ Centrifugal ☐ Other			
18. Elevation:			20. Water well contractor's certification: This well was drilled under my jurisdiction and this report is true to the best of my knowledge and belief. <u>Wm. H. Kull</u> <u>38</u> Business name <u>Cowich</u> <u>KS</u> License No. <u> </u> Address <u>Gardner</u> <u>KS</u> Authorized representative <u>8/28/78</u>			
19. Remarks: <u>Customer to furnish 4' x 4' x 4' slab around casing at grade</u> <u>Per State Regulations</u> <u>Sequester X Herbert Boehlke</u>						

Forward the white, blue and pink copies to the Department of Health and Environment

Form WWC-5