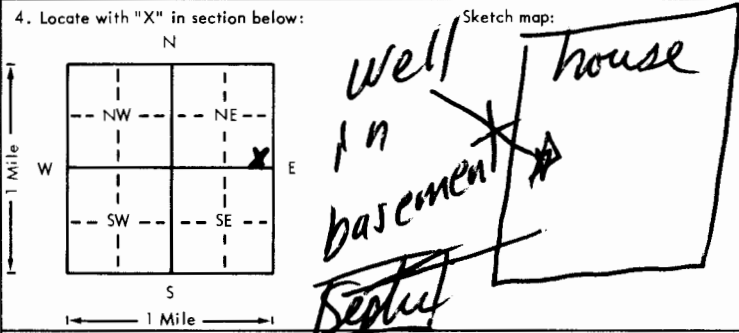


USE TYPEWRITER OR BALL
POINT PEN-PRESS FIRMLY,
PRINT CLEARLY.

WATER WELL RECORD
KSA 82a-1201-1215

Kansas Department of Health and
Environment-Division of Environment
(Water well Contractors)
Topeka, Kansas 66620

1. Location of well: County <u>Sedgwick</u> Fraction <u>SE 1/4 SE 1/4 NE 1/4</u> Section number <u>24</u> Township number <u>T 27 S</u> Range number <u>R 3 E</u>			
2. Distance and direction from nearest town or city: <u>1 W 1/2 No Boddard KS</u> Street address of well location if in city:		3. Owner of well: <u>Clarence Ray</u> R.R. or street: <u>503 No Fairfield</u> City, state, zip code: <u>Cheney KS 67025</u>	
4. Locate with "X" in section below: 		6. Bore hole dia. <u>1 1/2</u> in. Completion date: <u>5/16/78</u> Well depth <u>77</u> ft.	
5. Type and color of material		7. ☐ Cable tool ☒ Rotary ☐ Driven ☐ Dug ☐ Hollow rod ☐ Jetted ☐ Bored ☐ Reverse rotary	
From To		8. Use: ☒ Domestic ☐ Public supply ☐ Industry ☐ Irrigation ☐ Air conditioning ☐ Stock ☐ Lawn ☐ Oil field water ☐ Other	
Top soil 0 3 Red clay. 3 18 fine sand. 18 24 Charcoal shale 24 77		9. Casing: Material <u>Steel</u> Height: Above or below Threaded ☐ Welded ☒ Surface <u>12</u> in. RMP ☒ PVC ☐ Weight <u>1.50</u> lbs./ft. Dia. <u>5</u> in. to <u>77</u> ft. depth Wall Thickness: inches or Dia. <u>5</u> in. to <u>77</u> ft. depth gage No. <u>1200</u>	
		10. Screen: Manufacturer's name <u>Sunflower</u> Type <u>200</u> Dia. <u>5</u> in. Slot/gauze <u>1/16</u> Length <u>50 ft</u> Set between <u>27</u> ft. and <u>77</u> ft. <u>77</u> ft. and <u>77</u> ft. Gravel pack? <u>yes</u> Size range of material <u>3/8</u>	
		11. Static water level: <u>25</u> ft. below land surface Date: <u>5/16/78</u> 12. Pumping level below land surfaces: <u>70</u> ft. after <u>1 1/2</u> hrs. pumping <u>4</u> g.p.m. <u>70</u> ft. after <u>1 1/2</u> hrs. pumping <u>4</u> g.p.m. Estimated maximum yield <u>3-4</u> g.p.m.	
		13. Water sample submitted: <u>no.</u> /day/yr. ☐ Yes ☒ No Date <u>5/16/78</u>	
		14. Well head completion: <u>12</u> Inches above grade ☐ Pitless adapter	
		15. Well grouted? <u>yes</u> With: ☐ Neat cement ☐ Bentonite ☒ Concrete Depth: From <u>6</u> ft. to <u>16 ft</u>	
		16. Nearest source of possible contamination: ft. <u>75</u> Direction <u>SE</u> Type <u>Septic</u> Well disinfected upon completion? ☒ Yes ☐ No	
		17. Pump: ☒ Not installed Manufacturer's name <u>X</u> Model number <u>X</u> HP <u>X</u> Volts <u>X</u> Length of drop pipe <u>X</u> ft. capacity <u>X</u> g.p.m. Type: ☐ Submersible ☐ Turbine ☐ Jet ☐ Reciprocating ☐ Centrifugal ☐ Other	
18. Elevation:		20. Water well contractor's certification: This well was drilled under my jurisdiction and this report is true to the best of my knowledge and belief. <u>Wenger Drilling 318</u> Business name <u>Wenger Drilling</u> License No. <u>318</u> Address <u>Cheney KS</u> Signed <u>Wenger</u> Date <u>5/16/78</u> Authorized representative	
19. Remarks: Topography: ☒ Hill ☐ Slope ☐ Upland ☐ Valley			

Forward the white, blue and pink copies to the Department of Health and Environment

Form WWC-5