USE TYPEWRITER OR BALL POINT PEN-PRESS FIRMLY, PRINT CLEARLY.

WATER WELL RECORD
KSA 82a-1201-1215

Kansas Department of Health and Environment-Division of Environment
(Water well Contractors)
Topeka, Kansas 66620

1. Location of well:	County	Fraction	Section number	Township number	Range number
	Sedgwick	CE¼ NW 1/4 NW 1/4	27	T 27 S	R 3W E/W

2. Distance and direction from nearest town or city: #1 Well
Street address of well location if in city: 3/4 North of 54 Highway on the Viola Rd. Garden Plain, Kansas

3. Owner of well: Simon Cordell
R.R. or street: RR#1
City, state, zip code: Garded Plain, Kansas

4. Locate with "X" in section below:

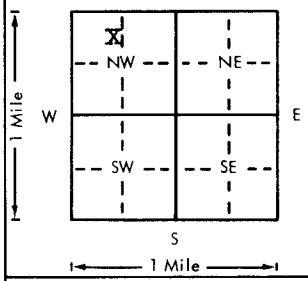

Sketch map:

5. Type and color of material	From	To
Topsoil	0	3
Red Clay	3	42
Fine Sand	42	48
Red Shale	48	79
Gray Shale	79	100
Limestone	100	105

(Use a second sheet if needed)

6. Bore hole dia. 11 in. Completion date
Well depth 105 ft. 4-8-77

7. __ Cable tool X Rotary __ Driven __ Dug
__ Hollow rod __ Jetted __ Bored __ Reverse rotary

8. Use: __ Domestic __ Public supply __ Industry
__ Irrigation __ Air conditioning __ Stock
X Lawn __ Oil field water __ Other

9. Casing: Material Styrene Height: Above or below ////
Threaded __ Welded gl Surface 12 in.
RMP X PVC __ Weight __ lbs./ft.
Dia. 5 in. to 105 ft. depth Wall Thickness: inches or
Dia. __ in. to __ ft. depth gage No. 200

10. Screen: Manufacturer's name Sunflower Plastic
Type Styrene Dia. 5"
Slot/gauze .06 Length 55'
Set between 50 ft. and 105 ft.
__ ft. and __ ft.
Gravel pack? yes Size range of material ½-1/8"

11. Static water level: mo./day/yr.
40 ft. below land surface Date 4-8-77

12. Pumping level below land surfaces:
__ ft. after __ hrs. pumping __ g.p.m.
__ ft. after __ hrs. pumping __ g.p.m.
Estimated maximum yield __ g.p.m.

13. Water sample submitted: mo./day/yr.
__ Yes __ No Date

14. Well head completion: Capped
__ Pitless adapter 12 Inches above grade

15. Well grouted? yes
With: __ Neat cement __ Bentonite X Concrete
Depth: From 40" ft. to 14 ft.

16. Nearest source of possible contamination: NONE
ft. __ Direction __ Type
Well disinfected upon completion? X Yes __ No

17. Pump: X Not installed
Manufacturer's name
Model number HP Volts
Length of drop pipe ft. capacity g.p.m.
Type:
__ Submersible __ Turbine
__ Jet __ Reciprocating
__ Centrifugal __ Other

18. Elevation:

Topography:
__ Hill
X Slope
__ Upland
__ Valley

19. Remarks: Septic System not installed when the well was drilled.
No apparent source for contamination.

20. Water well contractor's certification:
This well was drilled under my jurisdiction and this repart is true to the best of my knowledge and belief.
Business name Harp Well & Pump License No. 236
Address Wichita, Kansas
Signed M. Arnold Authorized representative Date 4-29-77

Farward the white, blue and pink copies to the Department of Health and Environment

Form WWC-5

27 - 3W - 27 CE¼ NW¼ NW¼
T R Sec 1/4 1/4 1/4

MI-1023