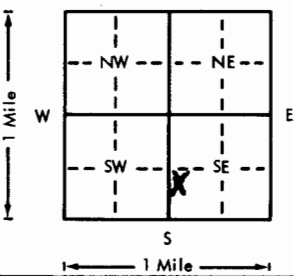
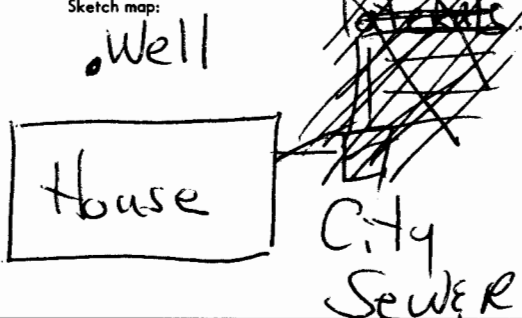


USE TYPEWRITER OR BALL
POINT PEN-PRESS FIRMLY,
PRINT CLEARLY.

WATER WELL RECORD
KSA 82a-1201-1215

Kansas Department of Health and
Environment-Division of Environment
(Water well Contractors)
Topeka, Kansas 66620

1. Location of well:		County <u>Sedg.</u>	Fraction <u>NW 1/4 SW 1/4 SE 1/4</u>	Section number <u>30</u>	Township number <u>27</u>	Range number <u>3</u>	<u>EW</u>
2. Distance and direction from nearest town or city:		<u>Garden Plain</u>		3. Owner of well: <u>Sidney Smarsh</u>			
Street address of well location if in city:		<u>1110 N. MAIN</u>		City, state, zip code: <u>Box 11-A Garden Plain KS 67050</u>			
4. Locate with "X" in section below:		Sketch map:		6. Bore hole dia. <u>8 3/4"</u> Completion date <u>4/23</u>			
				Well depth <u>50</u> ft.			
5. Type and color of material		From		To		7. Cable tool ☒ Rotary ☐ Driven ☐ Dug	
<u>Top soil</u>		<u>0</u>		<u>4</u>		☐ Hollow rod ☐ Jetted ☐ Bored ☐ Reverse rotary	
<u>Red clay</u>		<u>4</u>		<u>22</u>		8. Use: ☒ Domestic ☐ Public supply ☐ Industry	
<u>IF FINE Sand & Red clay</u>		<u>22</u>		<u>33</u>		☐ Irrigation ☐ Air conditioning ☐ Stock	
<u>coarse gravel</u>		<u>33</u>		<u>44</u>		☐ Lawn ☐ Oil field water ☐ Other	
<u>Red shale</u>		<u>44</u>		<u>50</u>		9. Casing: Material <u>Plst</u> Height: Above or below	
						Threaded ☐ Welded ☒ Surface <u>12</u> in.	
						RMP ☐ PVC ☒ Weight <u>2.00</u> lbs./ft.	
						Dia. <u>5</u> in. to <u>50</u> ft. depth Wall Thickness: inches	
						Dia. <u>5</u> in. to <u>50</u> ft. depth gage No. <u>190</u>	
						10. Screen: Manufacturer's name <u>J & L</u>	
						Type <u>Plst</u> Dia. <u>5 1/4</u>	
						Slot gauze <u>1/16</u> Length <u>10 ft</u>	
						Set between <u>40</u> ft. and <u>50</u> ft.	
						Gravel pack? <u>yes</u> Size range of material <u>1/8-3/8</u>	
						11. Static water level: <u>30</u> ft. below land surface Date <u>4/23/76</u>	
						12. Pumping level below land surfaces:	
						<u>32</u> ft. after <u>1/2</u> hrs. pumping <u>18</u> g.p.m.	
						<u> </u> ft. after <u> </u> hrs. pumping <u> </u> g.p.m.	
						Estimated maximum yield <u>60</u> g.p.m.	
						13. Water sample submitted: <u> </u> mo./day/yr.	
						Yes ☐ No ☒ Date <u> </u>	
						14. Well head completion:	
						<u> </u> Pitless adapter <u>12</u> inches above grade	
						15. Well grouted? <u>NO</u>	
						With: <u> </u> Neat cement <u> </u> Bentonite <u> </u> Concrete	
						Depth: From <u> </u> ft. to <u> </u> ft.	
						16. Nearest source of possible contamination:	
						ft. <u> </u> Direction <u> </u> Type <u> </u>	
						Well disinfected upon completion? ☒ Yes ☐ No	
						17. Pump:	
						☒ Not installed	
						Manufacturer's name <u> </u>	
						Model number <u> </u> HP <u> </u> Volts <u> </u>	
						Length of drop pipe <u> </u> ft. capacity <u> </u> g.p.m.	
						Type:	
						☐ Submersible ☐ Turbine	
						☐ Jet ☐ Reciprocating	
						☐ Centrifugal ☐ Other	
18. Elevation:		19. Remarks: <u>Customer to grout well with 10 ft cement and also 4x4x4 slab. He knows these are regulations</u>					
Topography:		20. Water well contractor's certification:					
☐ Hill		This well was drilled under my jurisdiction and this report is true to the best of my knowledge and belief.					
☐ Slope		<u>Wengerer Realty</u> 318					
☒ Upland		Business name <u>Goldwich KS</u> License No. <u> </u>					
☐ Valley		Address <u> </u> State <u> </u> Date <u>4/23/76</u>					
		Signed <u>Wengerer</u> Authorized representative					

Forward the white, blue and pink copies to the Department of Health and Environment

Form WWC-3